


STATE OF KANSAS
STATE CORPORATION COMMISSION

WELL PLUGGING RECORD

Give All Information Completely
Make Required Affidavit
Mail or Deliver Report to
Conservation Division
State Corporation Comm.
245 North Water
Wichita, KS 67202

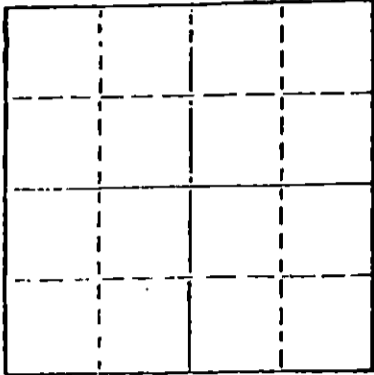

Locate well correctly on above
Section Plat

Pratt County, Sec. 25 Twp. 28S Rge. 14W E/W
Location as "NE/CNW $\frac{1}{4}$ SW $\frac{1}{4}$ " or footage from lines
SW NE SE

Lease Owner PICKRELL DRILLING COMPANY
Lease Name WHITEHEAD "A" Well No. 1

Office Address 205 LITWIN BLDG., WICHITA, KS. 67202

Character of Well (Completed as Oil, Gas or Dry Hole)
Dry Hole

Date Well completed 11-24-76 19

Application for plugging filed 11-24-76 19

Application for plugging approved 11-24-76 19

Plugging commenced 11-24-76 19

Plugging completed 11-24-76 19

Reason for abandonment of well or producing formation
Dry Hole

If a producing well is abandoned, date of last production
19

Was permission obtained from the Conservation Division or
its agents before plugging was commenced? Yes

Name of Conservation Agent who supervised plugging of this well G.R. Biberstein

Producing formation Depth to top Bottom Total Depth of Well 4561

Show depth and thickness of all water, oil and gas formations.

OIL, GAS OR WATER RECORDS

CASING RECORD

FORMATION	CONTENT	FROM	TO	SIZE	PUT IN	PULLED OUT
				8 5/8	376	None

Describe in detail the manner in which the well was plugged, indicating where the mud fluid was placed and the method or methods used in introducing it into the hold. If cement or other plugs were used, state the character of same and depth placed, from _____ feet to _____ feet for each plug set.

35 sacks at 300'

15 sacks at 40'

5 sacks in Rat Hole Job completed 9AM 11-24-76

RECEIVED
STATE CORPORATION COMMISSION

DEC 15 1976
12-15-76
Conservation Division
Wichita, Kansas

(If additional description is necessary, use BACK of this sheet)

Name of Plugging Contractor Pickrell Drilling Company

STATE OF Kansas COUNTY OF Sedgwick, ss.
C. W. Sebitts (employee of owner) or (owner or operator)

of the above-described well, being first duly sworn on oath, says: That I have knowledge of the facts, statements, and matters herein contained and the log of the above-described well as filed and that the same are true and correct. So help me God.

(Signature)

205 Litwin Bldg., Wichita, Ks. 67202

(Address)

SUBSCRIBED AND SWORN TO before me this 6 day of December, 1976

Jo Ann Sarver
Notary Public.

My commission expires



ROTARY DRILLING LOG

COMPANY: PICKRELL DRILLING COMPANY
205 LITWIN BLDG.
WICHITA, KS. 67202
LOCATION: WHITEHEAD "A" #1
SW NE SE 25-28S-14W
PRATT CO., KS.
CONTRACTOR: PICKRELL DRILLING COMPANY
Wichita, Kansas

Rotary Drilling Commenced 11-11-76
Rotary Drilling Completed 11-24-76

CASING RECORD: 8 5/8" surface casing set at 376' with 225 sacks.

LOG

(Figures indicate bottom of formation — measurements from top of rotary bushing.)

Surface	101
Sand Shale	380
Shale	840
Shale	1905
Lime & Shale	2165
Lime	2250
Lime & Shale	2416
Lime & Shale	2576
Lime	2720
Lime & Shale	2884
Lime & Shale	2935
Lime & Shale	3105
Lime & Shale	3230
Lime & Shale	3355
Lime & Shale	3515
Lime & Shale	3625
Lime & Shale	3755
Lime & Shale	3885
Sand, Lime & Shale	3910
Lime & Shale	3945
Lime & Shale	3986
Lime & Shale	4040
Lime & Shale	4115
Lime	4145
Lime & Shale	4167
Lime & Shale	4182
Lime & Shale	4250
Lime & Shale	4320
Lime & Shale	4357
Lime & Shale	4409
Lime & Shale	4461
Lime & Shale	4526
Lime & Shale	4531
Lime & Shale	4561

RECEIVED
STATE GEOLOGICAL COMMISSION

DEC 15 1976

CONSERVATION DIVISION
Wichita, Kansas

The undersigned, C. W. Sebitts, Attorney-in-Fact for PICKRELL DRILLING COMPANY, hereby certifies in behalf of said Company, that the above is a true and correct log of the formation encountered in drilling the above well as reflected by the Daily Drilling Reports.

PICKRELL DRILLING COMPANY
By [Signature]
Attorney-in-Fact
C. W. Sebitts

STATE OF KANSAS }
COUNTY OF SEDGWICK } ss.:

On this 6 day of December, 1976, before me the undersigned, a Notary Public, in and for the County and State aforesaid, personally appeared C. W. Sebitts, to me known to be the identical person who subscribed the name of PICKRELL DRILLING COMPANY to the foregoing instrument as its Attorney-in-Fact and acknowledged to me that he executed the same as his free and voluntary act and deed, and as the free and voluntary act and deed of such company, for the uses and purposes therein set forth.

Given under my hand and seal of office the day and year last above written.

My commission expires:



[Signature]
Notary Public
Jo Ann Sarver