

070674

S-5

API NUMBER 15- 129-20,978-0000

STATE CORPORATION COMMISSION
CONSERVATION DIVISION - PLUGGING SECTION
200 COLORADO DERBY BUILDING
WICHITA, KANSAS 67202

SE NW SW, SEC. 16, T 32 S, R 43 W/E

TECHNICIAN'S PLUGGING REPORT

Operator License # 6378

1650 feet from S section line

4290 feet from E section line

Operator: Hawkins Oil & Gas, Inc.

Lease Name Dryer "A" Well # 1-16

Name & Address P.O. Box 1282

County Morton 169.00

Liberal, KS 67905-1282

Well Total Depth 5200 feet

Conductor Pipe: Size feet

Surface Casing: Size 8 5/8 feet 1622

Abandoned Oil Well Gas Well Input Well SWD Well D&A X

Other well as hereinafter indicated

Plugging Contractor Murfin Drilling Company License Number 6033

Address 250 North Water, Suite 300, Wichita, KS 67202

Company to plug at: Hour: 3 a.m. Day: 5 Month: 5 Year: 19 89

Plugging proposal received from Tom Heskett

(company name) Murfin Drilling Company (phone) 316-267-3241

were: to fill hole with heavy mud and spot cement through drill pipe Elevation 3637' Anhydrite 1400'

1st plug at 3200' with 100 sx cement, 2nd plug at 1630' with 50 sx cement,

3rd plug at 800' with 40 sx cement, 4th plug at 40' with 10 sx cement,

5th plug to circulate rathole with 15 sx cement.

Plugging Proposal Received by Dan Goodrow (TECHNICIAN)

Plugging Operations attended by Agent?: All Part None X

Operations Completed: Hour: 6:30 a.m. Day: 5 Month: 5 Year: 19 89

ACTUAL PLUGGING REPORT 1st plug at 3200' with 100 sx cement,

2nd plug at 1630' with 50 sx cement,

3rd plug at 800' with 40 sx cement,

4th plug at 40' with 10 sx cement,

5th plug to circulate rathole with 15 sx cement.

RECEIVED STATE CORPORATION COMMISSION

MAY 26 1989

5-26-89

CONSERVATION DIVISION Wichita, Kansas

Remarks: Used 60/40 Pozmix 6% gel by Dowell. (if additional description is necessary, use BACK of this form.)

copy of this report observe this plugging.

Signed Dan Goodrow (TECHNICIAN)

INVOICED

DATE 5-26-89

INV. NO. 25935

NOTICE OF INTENTION TO DRILL

Must be approved by the K.C.C. five (5) days prior to commencing well

Expected Spud Date 4-25-89
month day year

C. SE. NW. SW. Sec 16 Twp 32S S, Rg 43 X Ea

OPERATOR: License # 6378
Name: Hawkins Oil & Gas, Inc.
Address: P. O. Box 1282
City/State/Zip: Liberal, Kansas 67905-1282
Contact Person: Frank Gagliardi
Phone: 918-585-3121

1650 feet from South line of Section
4290 feet from East line of Section

(Note: Locate well on Section Plat Below)

CONTRACTOR: License # 6033
Name: Murfin Drilling Company

County: Morton
Lease Name: Dryer "A" Well #: 1-16

Well Drilled For: 250 gal. Water Well Class: 300 Type Equipment:

Field Name: _____
Is this a Prorated Field? yes X no

- Oil Inj Infield Mud Rotary
- Gas Storage Pool Ext. Air Rotary
- OMD Disposal Wildcat Cable
- Seismic; # of Holes

Target Formation(s): Morrow

Hearst lease or unit boundary: 990'
Ground Surface Elevation: 3637' feet MSL

Domestic well within 330 feet: yes X no
Municipal well within one mile: yes X no

Depth to bottom of fresh water: 200' 250'
Depth to bottom of usable water: 450' 480'

Surface Pipe by Alternate: X 1 2
Length of Surface Pipe Planned to be set: 1500'

Length of Conductor pipe required: n/a
Projected Total Depth: 5200'

If OMD: old well information as follows:

Operator: _____
Well Name: _____
Comp. Date: _____ Old Total Depth _____

Formation at Total Depth: Morrow
Water Source for Drilling Operations: X well farm pond other

Directional, Deviated or Horizontal wellbore? yes X no
If yes, total depth locations: n/a

DWR Permit #: _____
Will Cores Be Taken?: yes X no
If yes, proposed zone: _____

500' Alt. I Req.

Spud - 4-24-89 - 1500' + 8'

PUSHER Tom Heskett

TD 5200' FORMATION MISS.

SURFACE PIPE 8 5/8" @ 1622'

ANHYDRITE 1400' ELEVATION 3637'

STARTING TIME & DATE 5-5-89

COMPLETION TIME & DATE 5-5-89

1st PLUG @ 3200 FT. W/ 100 SX

2nd PLUG @ 1630 FT. W/ 50 SX

3rd PLUG @ 800 FT. W/ 40 SX

4th PLUG @ 40 FT. W/ 10 SX

RAT HOLE CIRCULATED W/ 15 SX


60/60 62 MOUSE HOLE CIRCULATED W/ _____ SX

WATER WELL PLUGGED W/ _____ SX

CEMENT COMPANY Lawrence

TECHNICIAN D.G.

RECEIVED
STATE CORPORATION COMMISSION
MAY 26 1989
CONSERVATION DIVISION
Wichita, Kansas

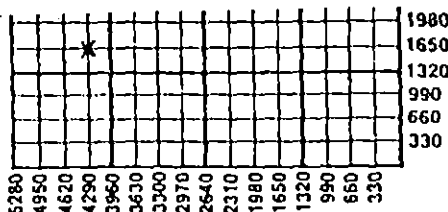

Wichita, Kansas

(in months or effective date.)
Spud date: _____ Agent: _____

REMEMBER TO:

- File Drill Pit Application (form CDP-1) with Intent to Drill;
- File Completion Form ACO-1 within 120 days of spud date;
- File acreage attribution plat according to field proration orders;
- Notify appropriate district office 48 hours prior to workover or re-entry;
- Submit plugging report (CP-4) after plugging is completed;
- Obtain written approval before disposing or injecting salt water.