


STATE OF KANSAS
STATE CORPORATION COMMISSION

Form CP-4

WELL PLUGGING RECORD

Give All Information Completely
Make Required Affidavit
Mail or Deliver Report to:
Conservation Division
State Corporation Commission
212 No. Market
Wichita, Kansas

NORTH

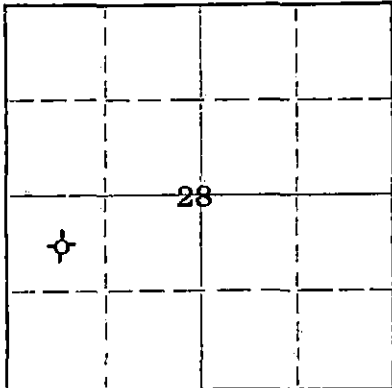

Locate well correctly on above
Section Plat

Pratt

County. Sec. 28 Twp. 28S Rge. (E) 12 (W)

Location as "NE/CNW/SW" or footage from lines NW SW

Lease Owner Rains & Williamson Oil Co., Inc. & Beacon Resources Corporation

Lease Name FIRST METHODIST CHURCH Well No. 1

Office Address 1425 Wichita Plaza - Wichita, Kansas

Character of Well (completed as Oil, Gas or Dry Hole) Dry Hole

Date well completed 8-29 19 67

Application for plugging filed 8-29 19 67

Application for plugging approved 8-29 19 67

Plugging commenced 8-29 19 67

Plugging completed 10:20 PM 8-29 19 67

Reason for abandonment of well or producing formation No oil or gas found in commercial quantities.

If a producing well is abandoned, date of last production -- 19 --

Was permission obtained from the Conservation Division or its agents before plugging was commenced? Yes

Name of Conservation Agent who supervised plugging of this well Archie Elving, Pratt, Kansas

Producing formation None Depth to top Bottom Total Depth of Well 3783 Feet

Show depth and thickness of all water, oil and gas formations.

OIL, GAS OR WATER RECORDS

CASING RECORD

FORMATION	CONTENT	FROM	TO	SIZE	PUT IN	PULLED OUT
				8-5/8"	402.87'	-0-

Describe in detail the manner in which the well was plugged, indicating where the mud fluid was placed and the method or methods used in introducing it into the hole. If cement or other plugs were used, state the character of same and depth placed, from feet to feet for each plug set.

Pushed plug to 300'. Cemented through
drill pipe with 25 sacks cement. Mudded
back to 40', set solid bridge and cemented 10
sacks cement, 2 sacks in rat hole.

RECEIVED
SEP 6 1967
CONSERVATION DIVISION
WICHITA, KANSAS

(If additional description is necessary, use BACK of this sheet)

Name of Plugging Contractor Rains & Williamson Oil Co., Inc.

Address 1425 Wichita Plaza - Wichita, Kansas 67202

STATE OF KANSAS, COUNTY OF SEDGWICK, ss.
Wilson Rains (Employee or owner) or (owner or operator) of the above-described

well, being first duly sworn on oath, says: That I have knowledge of the facts, statements, and matters herein contained and the log of the above-described well as filed and that the same are true and correct. So help me God.

(Signature) Wilson Rains Wilson Rains

1425 Wichita Plaza - Wichita, Kansas
(Address)

SUBSCRIBED AND SWORN TO before me this 5 day of September 1967

My commission expires June 30, 1971

Sherry Gish Gish Notary Public.

ROTARY DRILLING LOG

Operator: Rains & Williamson
Oil Co., Inc. and
Beacon Resources
Corporation
#1 FIRST METHODIST CHURCH
NW SW Section 28-28S-12W
Pratt County, Kansas

Contractor: Rains & Williamson
Oil Co., Inc.
Commenced: 8-24-67
Completed: 8-29-67

Remarks: Set 8-5/8" surface
casing at 402.87' w/
250 sacks GL-3 cement.

Formations

Soil and Clay	80'
Sand	250'
Shale	405'
Shale & Broken Anhydrite	1551'
Shale	1695'
Shale and Lime	1870'
Lime and Shale	2170'
Shale and Lime	2370'
Lime and Shale	2550'
Shale and Lime	2850'
Lime and Shale	3185'
Shale and Lime	3465'
Lime and Shale	3600'
Shale and Lime	3765'
Lime	3783'
Rotary Total Depth (D & A)	3783'


STATE CORPORATION
SEP 6 1967
CONSERVATION DIVISION
Wichita, Kansas

We certify the above log is
true and correct to the best
of our knowledge and belief.

RAINS & WILLIAMSON OIL CO., INC.


Wilson Rains

Subscribed and sworn to before me, a Notary Public, within and for the State
of Kansas, County of Sedgwick, this 5th day of September, 1967.

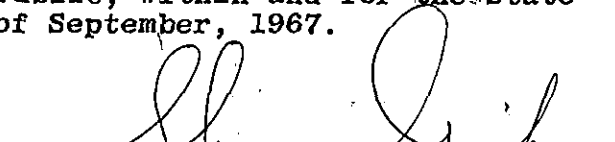
Sherry Gish Notary Public

My Commission Expires:
June 30, 1971