


STATE OF KANSAS  
STATE CORPORATION COMMISSION

WELL PLUGGING RECORD

Give All Information Completely  
Make Required Affidavit  
Mail or Deliver Report to:  
Conservation Division  
State Corporation Commission  
800 Bittling Building  
Wichita, Kansas

Pratt County. Sec. 28 Twp. 28S Rge. 12W (E).....(W)  
Location as "NE/CNW $\frac{1}{4}$ /SW $\frac{1}{4}$ " or footage from lines SE $\frac{1}{4}$  SE $\frac{1}{4}$  SW $\frac{1}{4}$   
Lease Owner Birmingham-Bartlett Drilling Co.  
Lease Name Dennis Well No. 1  
Office Address 300 Kaufman Building, Wichita 2, Kansas  
Character of Well (completed as Oil, Gas or Dry Hole) Dry Hole  
Date well completed May 27 19 51  
Application for plugging filed (verbal) May 27 19 51  
Application for plugging approved (verbally approved) May 27 19 51  
Plugging commenced May 27 19 51  
Plugging completed May 27 19 51  
Reason for abandonment of well or producing formation dry hole

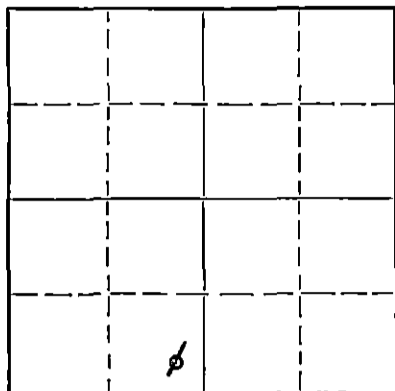

Locate well correctly on above  
Section Flat

If a producing well is abandoned, date of last production..... 19.....  
Was permission obtained from the Conservation Division or its agents before plugging was com-  
menced? Yes

Name of Conservation Agent who supervised plugging of this well M. A. Rives  
Producing formation Arbuckle Depth to top 4586 Bottom 4621 Total Depth of Well 4621 Feet  
Show depth and thickness of all water, oil and gas formations.

OIL, GAS OR WATER RECORDS

CASING RECORD

Formation	Content	From	To	Size	Put In	Pulled Out
		0	376'	8-5/8"	376'	None

Describe in detail the manner in which the well was plugged, indicating where the mud fluid was placed and the method or methods used in introducing it into the hole. If cement or other plugs were used, state the character of same and depth placed, from.....feet to.....feet for each plug set.

Plugged hole - filled hole to 200' with mud - bottom plug set at 200' with 15 sacks cement on top - top plug at 35' with 1/2 sack hulls and 10 sacks cement - orders of State Plugger

RECEIVED  
STATE CORPORATION COMMISSION  
6-1-51  
JUN - 1 1951  
CONSERVATION DIVISION  
WICHITA, KANSAS

(If additional description is necessary, use BACK of this sheet)

Correspondence regarding this well should be addressed to Birmingham-Bartlett Drilling Co.  
Address 300 Kaufman Building, Wichita 2, Kansas

STATE OF KANSAS COUNTY OF SEDGWICK  
E. L. Birmingham, Jr., partner of Birmingham-Bartlett Drilling Co., owner & operator  
being first duly sworn on oath, says: That I have knowledge of the facts, statements, and matters herein contained and the log of the above-described well as filed and that the same are true and correct. So help me God.  
(Signature) E. L. Birmingham Jr.  
300 Kaufman Building, Wichita 2, Kansas  
(Address)

SUBSCRIBED AND SWORN to before me this 29th day of May, 19 51  
Lincoln J. Gandy  
Notary Public.

My commission expires November 29, 1954.

28-5091-5 8-50-10M  
PLUGGING  
FILE SEC 28 T 28 R 12  
BOOK PAGE 84 LINE 41

DENNIS NO. 1

LOCATION: SE $\frac{1}{4}$  SE $\frac{1}{4}$  SW $\frac{1}{4}$  SEC. 28-28S-12W  
Pratt County, Kansas

OPERATOR: Birmingham-Bartlett Drilling Co.

CONTRACTOR: Birmingham-Bartlett Drilling Co.

SURFACE CASING: 8-5/8" casing cemented at 376' with  
235 sacks bulk cement and 2 c.c.

OIL STRING: None

SPUDED: 5-8-51

COMPLETED: 5-27-51

L O G

(Figures indicate bottom of formation)

0 to	260	Surface sand
	376	Red bed
	480	Red bed & Shale
	580	Sand & Shale
	730	Sand, Shale & Red bed
	745	Anhydrite
	1470	Shale & Shells
	1785	Shale
	2050	Lime & Shale
	2190	Lime
	2460	Lime & Shale
	2790	Shale & Shells
	2815	Sand & Shale
	2930	Shale & Shells
	3020	Shale & Lime
	3140	Sandy Lime & Shale
	3575	Lime & Shale
	3660	Sandy Lime & Shale
	3835	Shale & Lime
	3870	Lime
	3945	Lime & Shale
	4040	Lime
	4070	Lime & Shale
	4105	Lime
	4234	Shale & Lime
	4260	Cherty Lime
	4280	Cherty Lime & Shale
	4359	Shale & Shells
	4415	Shale & Lime
	4503	Lime
	4524	Shale & Sand
	4546	Simpson
	4560	Shale & Sand
	4588	Shale & Lime
	4621	Arbuckle
	4621	Total Depth

RECEIVED  
STATE CORPORATION COMMISSION  
JUN - 1 1951  
CONSERVATION DIVISION  
WICHITA, KANSAS

The undersigned, E. L. Birmingham, Jr. of the Birmingham-Bartlett Drilling Co., hereby certifies that the above is a true and correct log of the formations encountered in drilling the Dennis #1 Well as shown on the daily drilling reports.

BIRMINGHAM-BARTLETT DRILLING CO.

Subscribed and sworn before  
me this 29th day of May, 1951.

BY

*E. L. Birmingham, Jr.*

*W. J. Taylor*  
Notary Public

My commission expires November 29, 1954.

PLUGGING  
FILE SEC-28-T-28 D-12  
BOOK PAGE-84 LINE-41