


WELL PLUGGING RECORD

Give Information Completely  
Map Required Affidavit  
Mail or Deliver Report to:  
Conservation Division  
State Corporation Commission  
800 Bitting Building  
Wichita, Kansas

NORTH

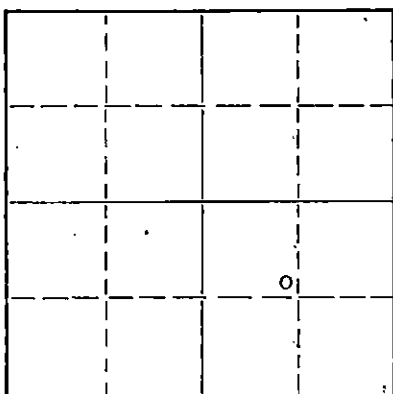

Locate well correctly on above  
Section Plat

Pratt County, Sec. 4 Twp. 28S Rge. 14W (X) (W)  
Location as "NE/CNW%SW%" or footage from lines SE NW SE  
Lease Owner Lario Oil & Gas Company  
Lease Name Patterson Well No. 1  
Office Address 301 South Market, Wichita, Kansas  
Character of Well (completed as Oil, Gas or Dry Hole) Dry Hole  
Date well completed December 13, 19 54  
Application for plugging filed December 13, 19 54  
Application for plugging approved December 13, 19 54  
Plugging commenced December 13, 19 54  
Plugging completed December 13, 19 54  
Reason for abandonment of well or producing formation Dry

If a producing well is abandoned, date of last production 19  
Was permission obtained from the Conservation Division or its agents before plugging was commenced? yes

Name of Conservation Agent who supervised plugging of this well M. A. Rives  
Producing formation Depth to top Bottom Total Depth of Well 4735' Feet  
Show depth and thickness of all water, oil and gas formations.

OIL, GAS OR WATER RECORDS

CASING RECORD

FORMATION	CONTENT	FROM	TO	SIZE	PUT IN	PULLED OUT
		0	365'	8 5/8"	365'	0

Describe in detail the manner in which the well was plugged, indicating where the mud fluid was placed and the method or methods used in introducing it into the hole. If cement or other plugs were used, state the character of same and depth placed, from feet to feet for each plug set.

4735' back to 300' with heavy rotary mud with one bridge plug with 20 sacks cement placed through drill pipe. 300' to 40' with heavy rotary mud and bridge plug with 10 sacks cement. Cement in 8 5/8" casing 4' below ground level.

12-16-54

(If additional description is necessary, use BACK of this sheet)

Name of Plugging Contractor Buick Drilling Inc.  
Address P. O. Box 331, St. John, Kansas


STATE OF Kansas, COUNTY OF Stafford, ss.  
H. R. Buick (employee of owner) or (owner or operator) of the above-described well, being first duly sworn on oath, says: That I have knowledge of the facts, statements, and matters herein contained and the log of the above-described well as filed and that the same are true and correct. So help me God.

(Signature) H. R. Buick  
P. O. Box 331, St. John, Kansas  
(Address)

SUBSCRIBED AND SWORN TO before me this 14th day of December, 19 54

My commission expires December 26, 1955.

Robertas Shogren  
Notary Public.

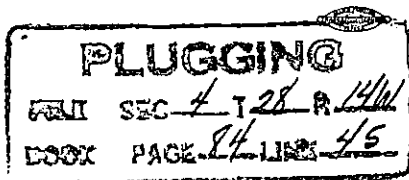

Drillers Log

Patterson #1  
 Commenced R.D.: 11-17-54  
 Completed R.D.: 12-12-54  
 Total Depth: 4735'  
 Casing Record: 365' of 8 5/8"

SE NW SE, Sec. 4-28S-14W,  
 Pratt County, Kansas  
 Elevation: 2022 D.F.  
 Initial Prod.: None  
 Contractor: Buick Drilling Inc.

STRATA	DEPTH
Sub soil and clay	0 - 95
Sand and gravel	95 - 205
Red Bed	205 - 240
Sand and gravel	240 - 255
Red bed	255 - 575
Red bed and shale	575 - 845
Anhydrite	845 - 885
Red bed and shale	885 - 1035
Red bed, shale and shells	1035 - 1120
Salt and shale	1120 - 1300
Shale and shells	1300 - 1935
Broken lime	1935 - 2055
Lime and shale	2055 - 3385
Lime	3385 - 3595
Lime and shale	3595 - 3623
Lime	3623 - 3705
Lime and shale	3705 - 3755
Lime	3755 - 3830
Lime and shale	3830 - 3965
Lime	3965 - 4095
Lime and shale	4095 - 4130
Lime	4130 - 4434
Chert and shale	4434 - 4470
Shale and lime	4470 - 4510
Chert	4510 - 4522
Chert and shale	4522 - 4636
Sand	4636 - 4655
Sand and shale	4655 - 4710
Lime and shale	4710 - 4735 T.D.

I hereby certify the above a true and correct drilling log as reflected by the drilling reports of the Buick Drilling Inc.

BUICK DRILLING INC.

*H. R. Buick*  
 H. R. Buick, President

Signed and sworn to in my presence this 14th day of December, 1954, by H. R. Buick, President of the Buick Drilling Inc.

*Roberta Anagnin*  
 Notary Public

My commission expires December 26, 1955.

**PLUGGING**  
 WELL SEC 4 T28 S14W  
 BOOK PAGE 24 LINE 45

RECEIVED  
 STATE COMMISSION  
 DEC 16 1954  
 CONSERVATION DIVISION  
 Wichita, Kansas