


STATE OF KANSAS
STATE CORPORATION COMMISSION

Form CP-4

Give All Information Completely
Make Required Affidavit
Mail or Deliver Report to:
Conservation Division
State Corporation Commission
212 No. Market
Wichita, Kansas

WELL PLUGGING RECORD

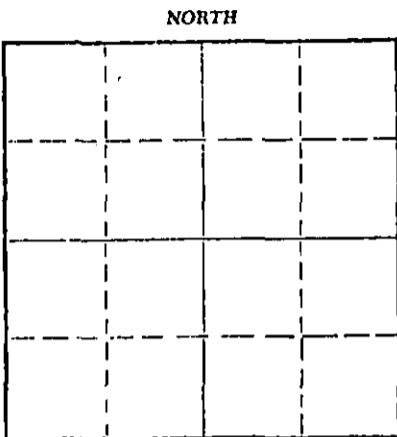

Locate well correctly on above Section Plat

Pratt County, Sec. 1 Twp. 28 Rge. 11 (E) (W) X
Location as "NE/CNW/SW" or footage from lines G SW NW
Lease Owner Pickrell Drilling Company
Lease Name La Velle Well No. A-1
Office Address 705 Fourth National Bank Building Wichita, Ks.
Character of Well (completed as Oil, Gas or Dry Hole)
Date well completed 19
Application for plugging filed 6-23-67 19
Application for plugging approved 6-24-67 19
Plugging commenced 6-24-67 19
Plugging completed 6-28-67 19
Reason for abandonment of well or producing formation

If a producing well is abandoned, date of last production 19
Was permission obtained from the Conservation Division or its agents before plugging was commenced? Yes

Name of Conservation Agent who supervised plugging of this well Archie V. Elving
Producing formation Depth to top Bottom Total Depth of Well 4602 Feet
Show depth and thickness of all water, oil and gas formations.

OIL, GAS OR WATER RECORDS

CASING RECORD

FORMATION	CONTENT	FROM	TO	SIZE	PUT IN	PULLED OUT
				8 5/8	346	None
				4 1/2	4 5/8	3791

RECEIVED
STATE CORPORATION COMMISSION
JUL 3 1967
CONSERVATION DIVISION
Wichita, Kansas

Describe in detail the manner in which the well was plugged, indicating where the mud fluid was placed and the method or methods used in introducing it into the hole. If cement or other plugs were used, state the character of same and depth placed, from feet to feet for each plug set.

Moved in. Cleaned out cellar.

Sanded to 4500'. Dumped 4 sacks of cement. Rigged up. Working pipe.

Working pipe. Shot pipe at 3790'. Pulling pipe.

Pulling pipe. Set plug at 350'. Mixed and dumped 5 sacks on plug - let set overnight.

Bailed down hole. Dumped 25 sacks of cement on bridge. Mudded hole to 40'. Set rock bridge 10' with 10 sacks for cap.

(If additional description is necessary, use BACK of this sheet)

Name of Plugging Contractor Forbes Casing Pulling, Inc.
Address P. O. Box 221 Great Bend, Kansas

STATE OF Kansas, COUNTY OF Barton, ss.
J. O. Forbes (employee of owner) or (owner or operator) of the above-described well, being first duly sworn on oath, says: That I have knowledge of the facts, statements, and matters herein contained and the log of the above-described well as filed and that the same are true and correct. So help me God.

(Signature) J. O. Forbes
P. O. Box 221 Great Bend, Kansas (Address)

SUBSCRIBED AND SWORN TO before me this 30 day of June, 1967

My commission expires May 27, 1969

Notary Public.

ROTARY DRILLING LOG

COMPANY: Pickrell Drilling Company
705 Fourth National Bank Bldg.
Wichita, Kansas

LOCATION: No. 1 LaVelle "A"
C SW NW Section 1-28S-14W
Pratt County, Kansas

CONTRACTOR: PICKRELL DRILLING COMPANY
Wichita, Kansas

Rotary Drilling Commenced 5/17/67
Rotary Drilling Completed 5/30/67

CASING RECORD: (16 jts.) 8 5/8" surface casing set at 346' and cemented with 225 sacks cement. Circulated. (114 jts.) 4 1/2" casing set at 4599' and cemented with 147 sacks cement. Completed 3:30 AM, May 30, 1967

LOG

(Figures indicate bottom of formation — measurements from top of rotary bushing.)

100	Sand	C. F. S.	4054
140	Sandy Clay		4105
343	Red Rock		4143
345	Shale		4185
805	Shale & Red Bed		4351
830	Lime		4460
1323	Shale		4471
2060	Lime & Shale		4500
2290	Lime		4510
2350	Shale		
2415	Lime & Shale		
2560	Lime	Slope Tests	2500
3115	Shale		3000
3455	Sandy Lime & Shale		3500
3730	Shale & Lime		4000
3938	Lime & Sand		
4054	Lime & Shale	S. L. M.	4083.64
4080	Lime	Board	4082.57
4105	Lime & Shale	Strap	1.07
4190	Lime	Difference	
4342	Lime & Shale		
4351	Mississippian		
4471	Lime & Gher		
4575	Simpson		
4602	Lime, RTD		

RECEIVED
STATE CORPORATION COMMISSION
JUN 26 1967
CONSERVATION DIVISION
Wichita, Kansas

The undersigned, C. W. SEBITS, Attorney-in-Fact for PICKRELL DRILLING COMPANY, hereby certifies in behalf of said Company, that the above is a true and correct log of the formation encountered in drilling the above well as reflected by the Daily Drilling Reports.

PICKRELL DRILLING COMPANY
By C. W. SEBITS, Attorney-in-Fact

STATE OF KANSAS }
COUNTY OF SEDGWICK } ss.:

On this 6th day of June, 1967, before me the undersigned, a Notary Public, in and for

the County and State aforesaid, personally appeared C. W. SEBITS, to me known to be the identical person who subscribed the name of PICKRELL DRILLING COMPANY to the foregoing instrument as its Attorney-in-Fact and acknowledged to me that he executed the same as his free and voluntary act and deed, and as the free and voluntary act and deed of such company, for the uses and purposes therein set forth.

Given under my hand and seal of office the day and year last above written.

My commission expires: May 10, 1970

L. M. Whiting
L. M. Whiting Notary Public