


STATE OF KANSAS
STATE CORPORATION COMMISSION

Give All Information Completely
Make Required Affidavit
Mail or Deliver Report to:
Conservation Division
State Corporation Commission
212 No. Market
Wichita, Kansas

WELL PLUGGING RECORD

Pratt County, Sec. 5 Twp. 28S Rge. 14 (E) W (W)

Location as "NE/CNW/SW" or footage from lines. SW NW
Lease Owner Lee Phillips Oil Company
Lease Name Hall Well No. 1
Office Address 1532 Wichita Plaza Bldg., Wichita, Kansas
Character of Well (completed as Oil, Gas or Dry Hole) Dry Hole
Date well completed 4-8 1969
Application for plugging filed 4-8 1969
Application for plugging approved 4-8 1969
Plugging commenced 4-8 1969
Plugging completed 4-8 1969
Reason for abandonment of well or producing formation Dry Hole

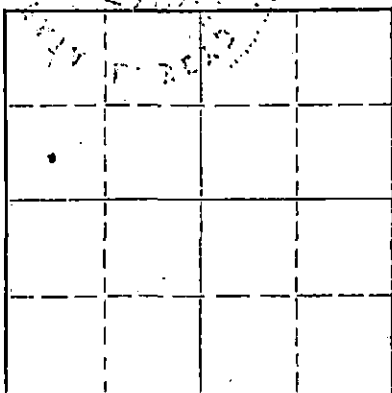

Locate well correctly on above
Section Plat

If a producing well is abandoned, date of last production 19
Was permission obtained from the Conservation Division or its agents before plugging was commenced? Yes

Name of Conservation Agent who supervised plugging of this well Jess Warren
Producing formation _____ Depth to top _____ Bottom _____ Total Depth of Well _____ Feet
Show depth and thickness of all water, oil and gas formations.

OIL, GAS OR WATER RECORDS

CASING RECORD

FORMATION	CONTENT	FROM	TO	SIZE	PUT IN	PULLED OUT
Surface pipe		-0-	419	8 5/8"	419	-0-

Describe in detail the manner in which the well was plugged, indicating where the mud fluid was placed and the method or methods used in introducing it into the hole. If cement or other plugs were used, state the character of same and depth placed, from _____ feet to _____ feet for each plug set.

Filled hole with heavy mud.
#1 plug set @ 240' with 25 sks. cement.
#2 plug set @ 40' with 10 sks. cement.
#3 plug in rat hole with 2 sks. cement.

RECEIVED
STATE CORPORATION COMMISSION
APR 21 1969
CONSERVATION DIVISION
Wichita, Kansas
4-21-69

(If additional description is necessary, use BACK of this sheet)
Name of Plugging Contractor Sweetman Drilling, Inc.
Address Box 645, Great Bend, Kansas 67530

STATE OF Kansas, COUNTY OF Barton, ss.
T. D. Sweetman (employee of owner) or (owner or operator) of the above-described well, being first duly sworn on oath, says: That I have knowledge of the facts, statements, and matters herein contained and the log of the above-described well as filed and that the same are true and correct. So help me God.

(Signature) T. D. Sweetman
Box 645, Great Bend, Kansas 67530
(Address)

SUBSCRIBED AND SWORN TO before me this 11th day of April, 1969
My commission expires 5-9-71



Heata L. Boyd
Notary Public.

WELL LOG
Hall # 1
SW NW 5-28S-14W
Pratt County, Kansas

<u>FROM</u>	<u>TO</u>	
0	210	Sand and clay
210	923	Red bed and shale
923	1925	Shale and shells
1925	3981	Shale and lime
3981	4448	Lime
4448	4624	Miss.
4624		Total Depth


Elevation: 2023' K.B.

RECEIVED
STATE CORPORATION COMMISSION
APR 21 1969
CONSERVATION DIVISION
Wichita, Kansas

STATE OF KANSAS

COUNTY OF BARTON ss

T. D. Sweetman, President of Sweetman Drilling, Inc., being first duly sworn on oath says: That I have knowledge of the facts, statements and matters herein contained and the log of the above described well as filed and that the same are true and correct.

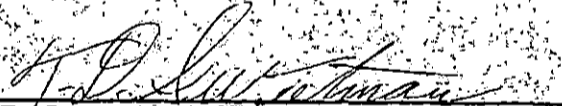
T. D. Sweetman

Subscribed and sworn before me this 11th day of April, 1969.


Notary Public Barton County

