


STATE OF KANSAS
STATE CORPORATION COMMISSION

WELL PLUGGING RECORD

Give All Information Completely
Make Required Affidavit
Mail or Deliver Report to
Conservation Division
State Corporation Comm.
245 North Water
Wichita, KS 67202

Pratt County, Sec. 5 Twp. 28S Rge. 14W E/W
Location as "NE/CNW 1/4 SW 1/4" or footage from lines
S/2 NE SW

Lease Owner PICKRELL DRILLING COMPANY
Lease Name COWEN "A" #1 Well No. _____
Office Address 205 LITWIN BLDG., WICHITA, KS.
Character of Well (Completed as Oil, Gas or Dry Hole)
DRY HOLE

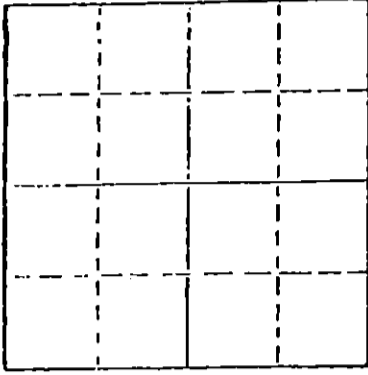

Locate well correctly on above
Section Plot

Date Well completed 11-09-79 19
Application for plugging filed 11-09-79 19
Application for plugging approved 11-09-79 19
Plugging commenced 11-09-79 19
Plugging completed 11-09-79 19
Reason for abandonment of well or producing formation
DRY HOLE

If a producing well is abandoned, date of last production
19

Was permission obtained from the Conservation Division or
its agents before plugging was commenced? Yes

Name of Conservation Agent who supervised plugging of this well William T. Owen
Producing formation _____ Depth to top _____ Bottom _____ Total Depth of Well 4495
Show depth and thickness of all water, oil and gas formations.

OIL, GAS OR WATER RECORDS

CASING RECORD

FORMATION	CONTENT	FROM	TO	SIZE	PUT IN	PULLED OUT
				8 5/8	468	None

Describe in detail the manner in which the well was plugged, indicating where the mud fluid
was placed and the method or methods used in introducing it into the hold. If cement or other
plugs were used, state the character of same and depth placed, from _____ feet to
_____ feet for each plug set.

50 sacks at 450'
10 sacks at 40' with bridge plug
5 sacks in rathole Comp. 7:45PM 11-9-79

RECEIVED
STATE CORPORATION COMMISSION

(If additional description is necessary, use BACK of this sheet)
Name of Plugging Contractor PICKRELL DRILLING COMPANY

11 1979
12-11-79
CONSERVATION DIVISION
Wichita, Kansas

STATE OF KANSAS COUNTY OF SEDGWICK
C. W. SEBITS (employee of owner) or (owner or operator)

of the above-described well, being first duly sworn on oath, says: That I have knowledge of
the facts, statements, and matters herein contained and the log of the above-described well
as filed and that the same are true and correct. So help me God. BY: C. W. Sebits


(Signature) *C. W. Sebits*
205 LITWIN BLDG., WICHITA, KS. 67202
(Address)

SUBSCRIBED AND SWORN TO before me this 19 day of November, 19 79

Carlene Lee
Notary Public.

My commission expires March 8, 1983

Carlene Lee

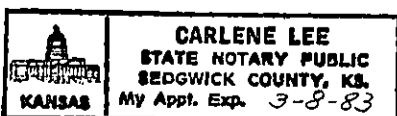

ROTARY DRILLING LOG

COMPANY: PICKRELL DRILLING COMPANY
 205 LITWIN BLDG.
 WICHITA, KS. 67202
 LOCATION: COWEN "A" #1
 S/2 NE SW Sec. 5-28S-14W
 PRATT CO., KS.
 CONTRACTOR: **PICKRELL DRILLING COMPANY**
 Wichita, Kansas

Rotary Drilling Commenced 10-28-79
 Rotary Drilling Completed 11-09-79

CASING RECORD:

Surf. casing set 8⁵/₈" set at 468' with 300sx.

LOG

(Figures indicate bottom of formation — measurements from top of rotary bushing.)

Top Soil & Clay	70
Sd. Strg. & Shale	180
Red Bed	300
Red Beds	470
Red Bed & Shale	900
Shale	1490
Shale	1937
Lime & Shale	2055
Shale & Lime	2185
Shale & Lime	2305
Lime & Shale	2465
Lime & Shale	2615
Lime & Shale	2750
Lime & Shale	2835
Lime & Shale	2965
Lime & Shale	3120
Lime & Shale	3250
Lime & Shale	3395
Lime & Shale	3580
Shale & Lime	3730
Shale & Lime	3850
Lime & Shale	3965
Lime	4035
Lime	4050
Lime & Shale	4130
Shale & Lime	4152
Lime	4175
Lime	4180
Lime	4240
Lime & Shale	4315
Lime & Shale	4375
Lime	4375
Lime	4475
Lime	4495

RECEIVED
 STATE CORPORATION COMMISSION
 DEC 11 1979
 CONSERVATION DIVISION
 Wichita, Kansas

The undersigned, C. W. Sebitts, Attorney-in-Fact for PICKRELL DRILLING COMPANY, hereby certifies in behalf of said Company, that the above is a true and correct log of the formation encountered in drilling the above well as reflected by the Daily Drilling Reports.

PICKRELL DRILLING COMPANY

By *C. W. Sebitts*
 Attorney-in-Fact
 C. W. Sebitts

STATE OF KANSAS }
 COUNTY OF SEDGWICK } ss.:

On this 19 day of November, 1979, before me the undersigned, a Notary Public, in and for

the County and State aforesaid, personally appeared C. W. Sebitts, to me known to be the identical person who subscribed the name of PICKRELL DRILLING COMPANY to the foregoing instrument as its Attorney-in-Fact and acknowledged to me that he executed the same as his free and voluntary act and deed, and as the free and voluntary act and deed of such company, for the uses and purposes therein set forth.

Given under my hand and seal of office the day and year last above written.

CARLENE LEE *March 8, 1983*
 My commission expires
 STATE NOTARY PUBLIC
 SEDGWICK COUNTY, KA.
 My Appt. Exp. 3-8-83
 KANSAS

Carlene Lee
 Notary Public
 Carlene Lee