


STATE OF KANSAS  
STATE CORPORATION COMMISSION

WELL PLUGGING RECORD

Give All Information Completely  
Make Required Affidavit  
Mail or Deliver Report to  
Conservation Division  
State Corporation Comm.  
245 North Water  
Wichita, KS 67202

Pratt County. Sec. 21 Twp. 28S Rge. 14 NE/W  
Location as "NE/CNW $\frac{1}{4}$ SW $\frac{1}{4}$ " or footage from lines  
SE NW

Lease Owner National Coop. Refinery Assn.  
Lease Name Leak Well No. 1  
Office Address Box 6, Great Bend, Ks.  
Character of Well (Completed as Oil, Gas or Dry Hole)  
dry hole

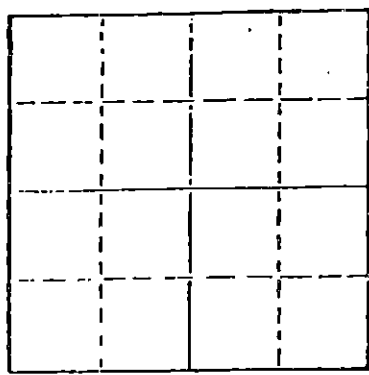

Date Well completed 3-15 1981  
Application for plugging filed 3-15 1981  
Application for plugging approved 3-15 1981  
Plugging commenced 3-15 1981  
Plugging completed 3-15 1981

Reason for abandonment of well or producing formation  
no commercial quantity of oil or gas encountered  
If a producing well is abandoned, date of last production  
-- 19

Was permission obtained from the Conservation Division or  
its agents before plugging was commenced? yes

Name of Conservation Agent who supervised plugging of this well Maurice Leslie  
Producing formation \_\_\_\_\_ Depth to top \_\_\_\_\_ Bottom \_\_\_\_\_ Total Depth of Well 4680  
Show depth and thickness of all water, oil and gas formations.

OIL, GAS OR WATER RECORDS

CASING RECORD

FORMATION	CONTENT	FROM	TO	SIZE	PUT IN	PULLED OUT
surface hole	shale	surf	318	8-5/8	310	none

Describe in detail the manner in which the well was plugged, indicating where the mud fluid was placed and the method or methods used in introducing it into the hold. If cement or other plugs were used, state the character of same and depth placed, from \_\_\_\_\_ feet to \_\_\_\_\_ feet for each plug set.

Fluid to 520', plug. 40 sx  
Fluid to 310', plug. 30 sx  
Fluid to 40', plug. 10 sx  
Rat hole 5 sx

(If additional description is necessary, use BACK of this sheet)

Name of Plugging Contractor D N B DRILLING, INC.  
515 R. H. Garvey Building  
Wichita, Kansas 67202

STATE OF Kansas COUNTY OF Sedgwick, ss.  
James L. Donelson, Jr. (employee of owner) or (owner or operator)

of the above-described well, being first duly sworn on oath, says: That I have knowledge of the facts, statements, and matters herein contained and the log of the above-described well as filed and that the same are true and correct. So help me God.

(Signature) *James L. Donelson, Jr.*  
515 R.H. Garvey Bldg., Wichita, Ks. 67202  
(Address)

SUBSCRIBED AND SWORN TO before me this 17th day of March, 19 81

My commission expires April 30, 1983

Dorothy L. Schmidt Notary Public.

RECEIVED  
STATE CORPORATION COMMISSION  
4-6-81  
APR - 6 - 1981  
CONSERVATION DIVISION  
Wichita, Kansas

DOROTHY L. SCHMIDT  
STATE NOTARY PUBLIC  
Sedgwick County, Kansas  
My Appt. Exp. April 30, 1983

DRILLER'S LOG

NATIONAL COOPERATIVE REFINERY ASSOCIATION

No. 1 Leak  
SE NW Sec. 21-28S-14W  
Pratt Co., Ks.

Commenced: 3-6-81  
Completed: 3-15-81

Surface Casing: 310' of 8-5/8"  
cmtd w/325' sx common, 2% gel,  
3% cc. 3-8-81

FORMATION

DEPTH

Surface Hole	0 - 318
Shale, Sand and Red Bed	318 - 1035
Shale and Red Bed	1035 - 1835
Shale & Lime	1835 - 2155
Lime & Shale	2155 - 3270
Lime, Shale & Sand	3270 - 3505
Lime & Shale	3505 - 4015
Lime	4015 - 4235
Lime & Shale	4235 - 4285
Lime	4285 - 4465
Lime & Shale	4465 - 4508
Lime	4508 - 4680 RTD

I do hereby certify that the foregoing statements are true and correct to the best of my knowledge and belief.

D N B DRILLING, INC.

*James L. Donelson, Jr.*

James L. Donelson, Jr.

STATE OF KANSAS: ss:

Subscribed and sworn to before me this 19th day of March, 1981

*Dorothy L. Schmidt*

Dorothy L. Schmidt, Notary Public

DOROTHY L. SCHMIDT  
STATE NOTARY PUBLIC  
Sedgwick County, Kansas  
My Appt. Exp. April 30, 1983