


WELL PLUGGING RECORD

Give All Information Completely  
Make Required Affidavit  
Mail or Deliver Report to:  
Conservation Division  
State Corporation Commission  
800 Bittig Building  
Wichita, Kansas

Pratt County, Sec. 15 Twp. 28S Rge. (E) 14 (W)

Location as "NE/CNW/SW" or footage from lines SW SW SE  
Lease Owner Lario Oil & Gas Co. et al  
Lease Name Woolfolk Well No. 1  
Office Address 301 So. Market, Wichita 2, Kansas  
Character of Well (completed as Oil, Gas or Dry Hole) Dry Hole  
Date well completed July 13, 19 54  
Application for plugging filed July 16, 19 54  
Application for plugging approved (Verbal 7-13-54) July 16, 19 54  
Plugging commenced July 14, 19 54  
Plugging completed July 14, 19 54  
Reason for abandonment of well or producing formation Dry

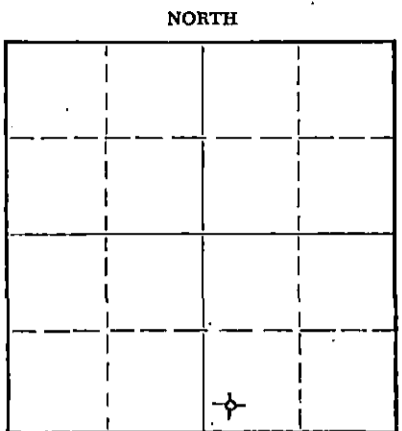

Locate well correctly on above Section Plat

If a producing well is abandoned, date of last production 19  
Was permission obtained from the Conservation Division or its agents before plugging was commenced? Yes

Name of Conservation Agent who supervised plugging of this well M. A. Rives, Box 8, Pratt, Kansas  
Producing formation Depth to top Bottom Total Depth of Well 4640 Feet  
Show depth and thickness of all water, oil and gas formations.

OIL, GAS OR WATER RECORDS

CASING RECORD

FORMATION	CONTENT	FROM	TO	SIZE	PUT IN	PULLED OUT
				8 5/8"	358	None

Describe in detail the manner in which the well was plugged, indicating where the mud fluid was placed and the method or methods used in introducing it into the hole. If cement or other plugs were used, state the character of same and depth placed, from feet to feet for each plug set.

Set plug at 300 feet and dumped 20 sacks cement through drill pipe. Set plug at 35 feet and run 10 sacks cement. (Well plugged at 3:30 A.M. 7-14-54)

(If additional description is necessary, use BACK of this sheet)

Name of Plugging Contractor Sterling Drilling Company  
Address Sterling, Kansas

STATE OF Kansas, COUNTY OF Sedgwick, ss.  
H. E. Miller (employee of owner) or (owner or operator) of the above-described well, being first duly sworn on oath, says: That I have knowledge of the facts, statements, and matters herein contained and the log of the above-described well as filed and that the same are true and correct. So help me God.

(Signature) x H. E. Miller  
301 So. Market, Wichita 2, Kansas (Address)

SUBSCRIBED AND SWORN TO before me this 20th day of July 1954

My commission expires July 21, 1954

Frances Leslie Notary Public.  
RECEIVED  
STATE CORPORATION COMMISSION

PLUGGING  
FILE SEC 15 T28 R14W  
BOOK PAGE 48 LINE 43

JUL 21 1954  
7-21-54  
CONSERVATION DIVISION  
Wichita, Kansas

LARIO OIL & GAS CO. ET AL  
 NO. 1 Woolfolk  
 SW SW SE Sec. 15-28S-14W  
 Pratt County, Kansas

Drilling Commenced: 6-20-54  
 Drilling Completed: 7-13-54  
 Drilling Contractor: Sterling Drilling Co.  
 Total Depth: 4640'  
 Initial Pot. - Dry

Formation:	Depth:
Surface	40
Sand & shale	350
Red bed	830
Anhydrite	855
Shale	890
Red bed, shale & shells	1200
Shale & shells	1400
Shale & lime	2255
Lime	2370
Lime & shale	2750
Shale & shells	2815
Shale & lime	3160
Lime	3750
Lime & shale	3795
Shale & sand	3900
Lime	4580
Shale	4586
Lime, Arbuckle	4640

Total Depth 4640'

Casing Record:  
 8 5/8" 358' Set @ 352.64 Cen. w/  
 300 sacks reg. cem.

Geological Tops:

	Elev.	1997 K.B.
Howard	3102	(-1105)
Topoka	3159	(-1162)
Seebner	3760	(-1763)
Toronto	3762	(-1785)
Base Oread	3808	(-1811)
Douglas Sand	3821	(-1824)
Brown Lime	3921	(-1924)
Lansing	3939	(-1942)
Conglomerate	4359	(-2362)
Viola	4451	(-2454)
Simpson	4509	(-2512)
Arbuckle	4590	(-2593)
T.D.	4640	(-2643)

\*\*\*\*\*

I hereby certify that this is a true and correct log of the above mentioned test.

*[Signature]*

STATE OF KANSAS

COUNTY OF SEDGWICK

ss:

Subscribed and sworn to before me, a notary public, in and for said County and State this 16th day of July, 1954.

*[Signature]*  
 Notary Public

My Commission expires July 21, 1954.

**PLUGGING**  
 FILE SEC 15 T 28 R 14W  
 BOOK PAGE 48 LINE 45

RECEIVED  
 JUL 17 1954  
 CONSERVATION DIVISION  
 Topeka, Kansas