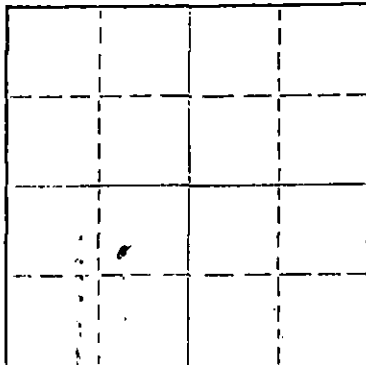


STATE OF KANSAS
STATE CORPORATION COMMISSION

Form CP-4

Give All Information Completely
Make Required Affidavit
Mail or Deliver Report to:
Conservation Division
State Corporation CommissionP. O. Box 17027
Wichita, Kansas 67217
NORTHLocate well correctly on above
Section Plat

WELL PLUGGING RECORD

Pratt County, Sec. 14 Twp. 28S Rge. 14W (E) (W)
 Location as "NE/CNW/SW" or footage from lines 1980' S line 990' W line
 Lease Owner Texas Energies
 Lease Name Lambert Well No. 1
 Office Address 306 Bank of Southwest Amarillo, Texas
 Character of Well (completed as Oil, Gas or Dry Hole) Oil & Gas
 Date well completed 11/18 19 74
 Application for plugging filed 19
 Application for plugging approved 19
 Plugging commenced 12-30 19 75
 Plugging completed 1-5 19 76
 Reason for abandonment of well or producing formation Dry
 If a producing well is abandoned, date of last production May 19 75
 Was permission obtained from the Conservation Division or its agents before plugging was commenced? Yes

Name of Conservation Agent who supervised plugging of this well Russell Bibberstien
 Producing formation _____ Depth to top _____ Bottom _____ Total Depth of Well 3980
 Show depth and thickness of all water, oil and gas formations.

OIL, GAS OR WATER RECORDS

CASING RECORD

FORMATION	CONTENT	FROM	TO	SIZE	PUT IN	PULLED OUT
				5 1/2		2600

Describe in detail the manner in which the well was plugged, indicating where the mud fluid was placed and the method or methods used in introducing it into the hole. If cement or other plugs were used, state the character of same and depth placed, from _____ feet to _____ feet for each plug set.

Pump 20 sks. of cement & 1 sk. of hulls from 3975 to 3850

Pump 10 sks. of gel & 1 sk. of hulls & 100 sks. of cement from 300 to 0 ft.

RECEIVED
STATE CORPORATION COMMISSION

FEB 6 1976
2-6-76
CONSERVATION DIVISION
Wichita, Kansas

(If additional description is necessary, use BACK of this sheet)
 Name of Plugging Contractor Sargents Casing Pulling Service
 Address Box 506 Liberal, Kansas 67901

STATE OF Kansas COUNTY OF Seward, ss.
Nesco, Inc. (employee of owner) or (owner or operator) of the above-described

well, being first duly sworn on oath, says: That I have knowledge of the facts, statements, and matters herein contained and the log of the above-described well as filed and that the same are true and correct. So help me God.

(Signature) Marionne Smith
Box 379, Liberal, Kansas (Address)

Subscribed and Sworn to before me this 26th day of January, 19 76

My commission expires Dec. 2, 1977

Notary Public.

