


STATE OF KANSAS
STATE CORPORATION COMMISSION

WELL PLUGGING RECORD

Give All Information Completely
Make Required Affidavit
Mail or Deliver Report to
Conservation Division
State Corporation Comm.
245 North Water
Wichita, KS 67202

Ford County, Sec. 22 Twp. 29S Rge. 22 ~~XX~~/~~XX~~W
Location as "NE/CNW $\frac{1}{4}$ SW $\frac{1}{4}$ " or footage from lines
C SE NE

Lease Owner Murfin Drilling Company
Lease Name Vanatta Well No. 1-22
Office Address 617 Union Center Bldg., Wichita, KS 67202
Character of Well (Completed as Oil, Gas or Dry Hole)

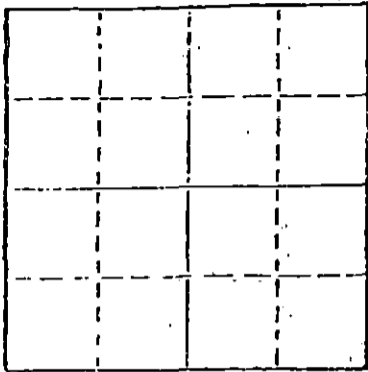

Dry Hole
Date Well completed 8-31-81 19
Application for plugging filed 8-31-81 19
Application for plugging approved 8-31-81 19
Plugging commenced 8-31-81 19
Plugging completed 8-31-81 19

Reason for abandonment of well or producing formation
Dry Hole
If a producing well is abandoned, date of last production 19.

Was permission obtained from the Conservation Division or its agents before plugging was commenced? Yes

Name of Conservation Agent who supervised plugging of this well Clarence Thomas
Producing formation Depth to top Bottom Total Depth of Well 5750'
Show depth and thickness of all water, oil and gas formations.

OIL, GAS OR WATER RECORDS

CASING RECORD

FORMATION	CONTENT	FROM	TO	SIZE	PUT IN	PULLED OUT
				8-5/8,	597'	none

Describe in detail the manner in which the well was plugged, indicating where the mud fluid was placed and the method or methods used in introducing it into the hold. If cement or other plugs were used, state the character of same and depth placed, from _____ feet to _____ feet for each plug set.

- 1st plug @ 850' w/60 sx
- 2nd plug @ 575' w/40 sx
- 3rd plug @ 40' w/10 sx
- 5 sx in rat hole
- 5 sx in mouse hole

2-22-81

RECEIVED
STATE CORPORATION COMMISSION

(If additional description is necessary, use BACK of this sheet)

Name of Plugging Contractor Murfin Drilling Co. SEP 22 1981

STATE OF Kansas COUNTY OF Sedgwick CONSERVATION DIVISION
Wichita Kansas

David L. Murfin, Drlg. Mgr. (employee of owner) or (owner or operator)
of the above-described well, being first duly sworn on oath, says: That I have knowledge of the facts, statements, and matters herein contained and the log of the above-described well as filed and that the same are true and correct. So help me God.

RAMONA GUNN
STATE NOTARY PUBLIC
Sedgwick county, Kans.
My Appt. Exp. _____

(Signature) *David L. Murfin*
David L. Murfin, Drlg. Mgr. 617 Union Center
(Address) Wichita, KS 67202

SUBSCRIBED AND SWORN TO before me this 18th day of Sept., 1981

My commission expires Jan. 25, 1984

Ramona Gunn
Ramona Gunn Notary Public.

WELL LOG

COMPANY Murfin Drilling Co.
FARM Vanatta NO. 1-22
RIG. NO. 22
TOTAL DEPTH 5750
COMM. 8-12-81 COMP. 8-31-81
CONTRACTOR Murfin Drilling Co.

SEC. 22 29S 22W
LOC. C SE 1/4 NE R.

COUNTY Ford
KANSAS
[Grid]

CASING
20 10
15 8-5/8" @ 597' w/250 sx Howco Lite & 150 sx Gannett 3% CC
12 6
13 5
PRODUCTION

FIGURES INDICATE BOTTOM OF FORMATIONS

Surface Soil & Shale 96
Sand & Shale, Red Bed 1325
Lime & Shale RTD 5750

RECEIVED
STATE CORPORATION COMMISSION
SEP 22 1981
CONSERVATION DIVISION
Wichita, Kansas

State of Kansas
County of Sedgwick

I, David L. Murfin, Drlg. Mgr. of the Murfin Drilling Company

upon oath state that the above and foregoing is a true and correct copy of the log of the Vanatta #1-22 well.

RAMONA GUNN
STATE NOTARY PUBLIC
Sedgwick county, Kansas
My Appt. Exp. 18th

David L. Murfin
Ramona Gunn NOTARY PUBLIC

Subscribed and sworn to before me this 18th day of September 1981
My Commission Expires: Jan. 25, 1984