

CARD MUST BE TYPED

State of Kansas

CARD MUST BE SIGNED

NOTICE OF INTENTION TO DRILL

(see rules on reverse side)

Expected Spud Date..... February 15, 1988
month day year

API Number 15-151-21,879-00-00 ✓ 0,6

OPERATOR: License #..... 8887
Name..... KACHINA OIL COMPANY, INC.
Address..... 300 West Douglas - Suite 635
City/State/Zip..... Wichita, Kansas 67202
Contact Person..... Chas Sanders
Phone..... 316/262-2531

NE.. SE.. SE.. Sec...31.. Twp...29 S, Rg...12... X East
West
990 Ft. from South Line of Section
330 Ft. from East Line of Section

(Note: Locate well on Section Plat on reverse side)

CONTRACTOR: License #..... 5929
Name..... DUKE DRILLING CO., INC.
City/State..... Great bend, Kansas 67530

Nearest lease or unit boundary line 330 feet
County..... Pratt

Lease Name..... Hager Well # 1

Ground surface elevation 1888 feet MSL

Domestic well within 330 feet: _____yes Xno

Municipal well within one mile: _____yes Xno

Well Drilled For: Well Class: Type Equipment:
X Oil _____ Storage X Infield X Mud Rotary
_____ Gas _____ Inj _____ Pool Ext. _____ Air Rotary
_____ OWWO _____ Expl _____ Wildcat _____ Cable

Depth to bottom of fresh water..... 220

Depth to bottom of usable water 220

Surface pipe by Alternate: 1 X 2 _____

IF OWWO: old well info as follows:

Surface pipe planned to be set 240

Operator
Well Name
Comp Date..... Old Total Depth.....

Conductor pipe required

Projected Total Depth 4400 feet

Formation.....

I certify that well will comply with K.S.A. 55-101, et seq., plus eventually plugging hole to KCC specifications.

Date 2/10/88 Signature of Operator or Agent Sally R. Byers Title Agent

For KCC Use:

Conductor Pipe Required feet; Minimum Surface Pipe Required 240 feet per Alt. 1 X

This Authorization Expires 8-11-88 Approved By Patt 2-11-88


EFFECTIVE DATE: 2-16-88

Must be filed with the K.C.C. five (5) days prior to commencing well
This card void if drilling not started within six (6) months of date received by K.C.C.

Important procedures to follow:

1. Notify District office before setting surface casing.
2. Set surface casing by circulating cement to the top.
3. File completion forms ACO-1 with K.C.C. within 120 days of well spud date, following instructions on ACO-1, side 1, and including copies of wireline logs.
4. Notify District office 48 hours prior to old well workover or re-entry.
5. Prior to filing Intent, prepare a proposed plugging plan in case well is D & A, then obtain approval of plan when calling district office prior to setting surface pipe.
6. Submit plugging report (CP-4) to K.C.C. after plugging is completed.
7. Obtain an approved injection docket number before disposing of salt water.
8. Notify K.C.C. within 10 days when injection commences or terminates.
9. If an alternate 2 completion, cement in the production pipe from below any usable water to surface within 120 days of spud date.

A Regular Section of Land
1 Mile = 5,280 Ft.

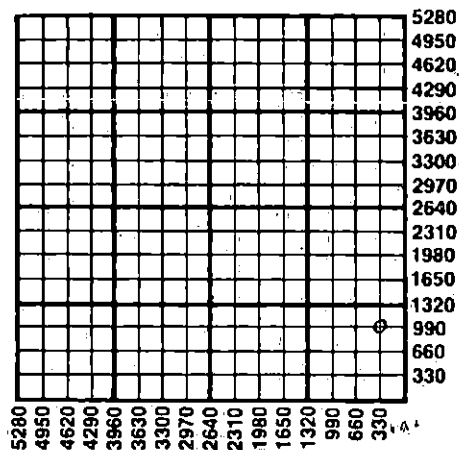

FEB 11 1988

Wichita, Kansas

State Corporation Commission of Kansas
Conservation Division
200 Colorado Derby Building
Wichita, Kansas 67202-1212
(316) 263-3238