


STATE OF KANSAS
STATE CORPORATION COMMISSION

WELL PLUGGING RECORD

Give All Information Completely
Make Required Affidavit
Mail or Deliver Report to:
Conservation Division
State Corporation Commission
800 Bittling Building
Wichita, Kansas

NORTH

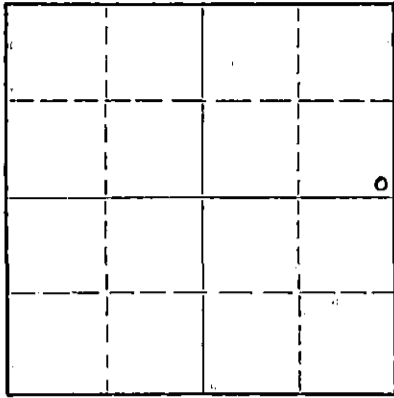

Locate well correctly on above
Section Plat

Kiowa County. Sec. 34 Twp. 29S Rge. (E) 16 (W)
Location as "NE/CNW/SW" or footage from lines SE SE NE
Lease Owner Graham-Miller Oil Company
Lease Name Betzer Well No. 3
Office Address 1005 East Second, Wichita, Kansas
Character of Well (completed as Oil, Gas or Dry Hole) Dry Hole
Date well completed December 5, 1955 19
Application for plugging filed December 5, 1955 (verbal) 19
Application for plugging approved December 5, 1955 (verbal) 19
Plugging commenced December 6, 1955 19
Plugging completed December 6, 1955 19
Reason for abandonment of well or producing formation Dry Hole

If a producing well is abandoned, date of last production _____ 19____
Was permission obtained from the Conservation Division or its agents before plugging was commenced? Yes

Name of Conservation Agent who supervised plugging of this well M. A. Rives, Box 8, Pratt, Kansas
Producing formation _____ Depth to top _____ Bottom _____ Total Depth of Well 4770 Feet
Show depth and thickness of all water, oil and gas formations.

OIL, GAS OR WATER RECORDS

CASING RECORD

FORMATION	CONTENT	FROM	TO	SIZE	PUT IN	PULLED OUT
				8 5/8	260'	None

Describe in detail the manner in which the well was plugged, indicating where the mud fluid was placed and the method or methods used in introducing it into the hole. If cement or other plugs were used, state the character of same and depth placed, from _____ feet to _____ feet for each plug set.

Filled hole with mud to 260'.
Set plug. Dumped 20 sacks
cement. Filled with mud to
35'. Set plug. Dumped 1/2
sack hulls and 10 sacks cement.

(If additional description is necessary, use BACK of this sheet)
Name of Plugging Contractor Graham-Messman-Rinehart Drilling Co. (License No. 20)
Address 1005 East Second, Wichita, Kansas

STATE OF Kansas, COUNTY OF Sedgwick, ss.
J. A. Gilliland (employee of owner) of the above-described well, being first duly sworn on oath, says: That I have knowledge of the facts, statements, and matters herein contained and the log of the above-described well as filed and that the same are true and correct. So help me God.

(Signature) J. A. Gilliland
1005 East Second, Wichita, Kansas
(Address)

SUBSCRIBED AND SWORN TO before me this 9th day of December, 19 55

My commission expires November 5, 1958

Juanita L. Davis
Notary Public.

PLUGGING
FILE REC-34T-29R-16W
BOOK PAGE 32 LINE 12

NO. 3 BETZNER

WELL LOG

Location: SE SE NE, 34-298-16W
 Kiowa County, Kansas

Operator: Gramhart-Miller Oil Company
 1005 East Second, Wichita, Kansas

Contractor: Graham-Mossman-Rinehart Drilling Co.
 1005 East Second, Wichita, Kansas

Casing Record: 8 5/8" @ 260' w/180 sacks cement

Commenced: November 21, 1955
 Completed: December 6, 1955
 Elevation: 1920 KB (1915 GL)
 Production: D&A

....L O G....

Shale	60
Red Bed	100
Sand	130
Red Bed	600
Red Bed-Shale	1115
Shale-Shells	2000
Lime-Shale	2155
Lime	2350
Lime-Shale	3516
Lime	3722
Lime-Shale	3855
Lime	4595
Conglomerate	4640
Lime-Chert	4770 R.F.D.

Sample Tops:

Heebner 3867 (-1947)
 Brn Lime 4030 (-2110)
 Lansing 4044 (-2124)
 Conglomerate 4580 (-2660)
 Viola 4640 (-2720)

The undersigned, GRAHAM-MOSSMAN-RINEHART DRILLING COMPANY, hereby certifies that the above log is a true and correct log of the formation encountered in drilling the above well as reflected by the Daily Drilling Report.

GRAHAM-MOSSMAN-RINEHART DRILLING COMPANY

By: J. A. Gilliland
 J. A. Gilliland

Subscribed and sworn to before me
 this 9th day of December 1955.

Quanta L. Davis
 Notary Public

My Commission Expires: November 5, 1958

PLUGGING
 FILE SEC 34-29-R-16W
 BOOK PAGE 22 LINE 12