


STATE OF KANSAS  
STATE CORPORATION COMMISSION  
CONSERVATION DIVISION  
P. O. BOX 17027  
WICHITA, KANSAS 67217

FORM CP-4

WELL PLUGGING RECORD

Kiowa County, Sec. 34 Twp. 29S Rge. 16 (E) X (W)  
SE NW NE

NORTH

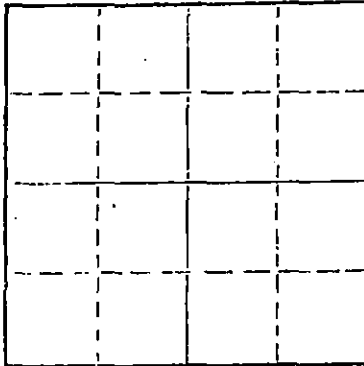

Locate well correctly on above Section Plot

Location as "NE/CNWKSW" or footage from lines. SE NW NE  
Lease Owner Icer Addis  
Lease Name Dannebohn Well No. 2  
Office Address P. O. Drawer 8038, Wichita, Kansas  
Character of Well (completed as Oil, Gas or Dry Hole) Dry Hole  
Date well completed September 20 1975  
Application for plugging filed September 20 1975  
Application for plugging approved September 20 1975  
Plugging commenced September 20 1975  
Plugging completed September 20 1975  
Reason for abandonment of well or producing formation Dry Hole

If a producing well is abandoned, date of last production 10  
Was permission obtained from the Conservation Division or its agents before plugging was commenced? Yes, verbally

Name of Conservation Agent who supervised plugging of this well G. R. Biberstein  
Producing formation \_\_\_\_\_ Depth to top \_\_\_\_\_ Bottom \_\_\_\_\_ Total Depth of Well 691 Feet  
Show depth and thickness of all water, oil and gas formations.

OIL, GAS OR WATER RECORDS

CASING RECORD

| FORMATION | CONTENT | FROM | TO | SIZE   | PUT IN | PULLED OUT |
|-----------|---------|------|----|--------|--------|------------|
|           |         |      |    | 8-5/8" | 315    |            |
|           |         |      |    |        |        |            |
|           |         |      |    |        |        |            |
Describe in detail the manner in which the well was plugged, indicating where the mud fluid was placed and the method or methods used in introducing it into the hole. If cement or other plugs were used, state the character of same and depth placed, from \_\_\_\_\_ feet to \_\_\_\_\_ feet for each plug set.

1st plug set at 250' with 35 sacks  
2nd plug set at 40' with 15 sacks, two sacks in rat hole

(If additional description is necessary, use BACK of this sheet)

Name of Plugging Contractor Union Drilling Co., Inc.  
Address 505 Union Center, Wichita, Kansas

STATE OF Kansas COUNTY OF Sedgwick ss.  
R. D. Messinger (employee of owner) or (owner or operator) of the above-described

well, being first duly sworn on oath, says: That I have knowledge of the facts, statements, and matters herein contained and the log of the above-described well as filed and that the same are true and correct. So help me God.

(Signature) R. D. Messinger  
505 Union Center, Wichita, Kansas (Address)

SUBSCRIBED AND SWORN TO before me this 1st day of October, 1975

My commission expires July 29, 1978

Donna F. Brown  
Donna F. Brown Notary Public.



RECEIVED  
STATE CORPORATION COMMISSION  
OCT 21 1975 10-21-75  
CONSERVATION DIVISION  
Wichita, Kansas

CONTRACTOR'S WELL LOG

OPERATOR: Icer Addis  
 CONTRACTOR: Union Drilling Co., Inc.  
 WELL NAME: #2 Dannebohn  
 LOCATION: SE NW NE Sec. 34-29-16W  
 Kiowa County, Kansas  
 COMMENCED: September 10, 1975  
 COMPLETED: September 20, 1975

|      |      |                |                                 |
|------|------|----------------|---------------------------------|
| 0    | 835  | Sand and shale | 8-5/8" casing set at 315' w/250 |
| 835  | 1515 | Shale          | sacks                           |
| 1515 | 4469 | Lime and Shale |                                 |
| 4469 | 4587 | Lime           |                                 |
| 4587 | 4645 | Lime and Shale |                                 |
| 4645 | 4659 | Lime           |                                 |
| 4659 | 4669 | Lime and Shale |                                 |
| 4669 | 4691 | Lime and Chert |                                 |
| 4691 |      | T. D.          |                                 |

RECEIVED  
 STATE CORPORATION COMMISSION  
 OCT 21 1975  
 CONSERVATION DIVISION  
 Wichita, Kansas

We certify that the above and foregoing is a true and correct copy of the log on the #2 Dannebohn, SE NW NE Section 34, 29S-16W, Kiowa County, Kansas.

UNION DRILLING CO., INC.

*R. D. Messinger*  
 R. D. Messinger

STATE OF KANSAS )  
 ) SS  
 COUNTY OF SEDGWICK )

Subscribed and sworn to before me, a Notary Public in and for the aforesaid county and state as of this 1st day of October, 1975.

*Donna F. Brown*  
 Donna F. Brown - Notary Public

My commission expires:

July 29, 1978

