


STATE OF KANSAS  
STATE CORPORATION COMMISSION

WELL PLUGGING RECORD

Give All Information Completely  
Make Required Affidavit  
Mail or Deliver Report to:  
Conservation Division  
State Corporation Commission  
800 Bittling Building  
Wichita, Kansas

Kiowa County. Sec. 34 Twp. 29S Rge. (E) 16 (W)

NORTH

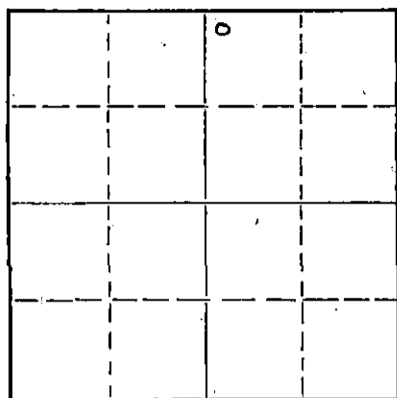

Locate well correctly on above  
Section Plat

Location as "NE/CNW/SW" or footage from lines App NW NW NE  
Lease Owner Grahamhart-Miller Oil Company  
Lease Name Betzer Well No. 2  
Office Address 1005 East Second, Wichita, Kansas  
Character of Well (completed as Oil, Gas or Dry Hole) Dry Hole  
Date well completed Nov. 19, 1955 19  
Application for plugging filed Nov. 19, 1955 (verbal) 19  
Application for plugging approved Nov. 19, 1955 (verbal) 19  
Plugging commenced Nov. 19, 1955 19  
Plugging completed Nov. 19, 1955 19  
Reason for abandonment of well or producing formation Dry Hole

If a producing well is abandoned, date of last production \_\_\_\_\_ 19  
Was permission obtained from the Conservation Division or its agents before plugging was commenced? Yes

Name of Conservation Agent who supervised plugging of this well M. A. Rives, Pratt, Kansas  
Producing formation \_\_\_\_\_ Depth to top \_\_\_\_\_ Bottom \_\_\_\_\_ Total Depth of Well 4985 Feet  
Show depth and thickness of all water, oil and gas formations.

OIL, GAS OR WATER RECORDS

CASING RECORD

FORMATION	CONTENT	FROM	TO	SIZE	PUT IN	PULLED OUT
				8 5/8"	255'	None

Describe in detail the manner in which the well was plugged, indicating where the mud fluid was placed and the method or methods used in introducing it into the hole. If cement or other plugs were used, state the character of same and depth placed, from \_\_\_\_\_ feet to \_\_\_\_\_ feet for each plug set.

Filled hole with mud  
to 250 feet. Set plug  
w/20 sacks cement.  
Filled hole with mud  
to 35 feet. Set plug.  
Used 1/2 sack hulls and 10  
sacks cement. (Cement to  
bottom of cellar.) Mud to  
surface

STATE CORPORATION COMMISSION

NOV 23 1955

CONSERVATION DIVISION  
11-23-55  
WICHITA, KANSAS

(If additional description is necessary, use BACK of this sheet)  
Name of Plugging Contractor Graham-Messman-Rinehart Drilling Company (License No. 20)  
Address 1005 East Second, Wichita, Kansas

STATE OF Kansas, COUNTY OF Sedgwick, ss.  
J. A. Gilliland (employee of owner) or (~~owner~~) of the above-described well, being first duly sworn on oath, says: That I have knowledge of the facts, statements, and matters herein contained and the log of the above-described well as filed and that the same are true and correct. So help me God.

(Signature) J. A. Gilliland  
1005 East Second, Wichita, Kansas  
(Address)

SUBSCRIBED AND SWORN to before me this 22nd day of November, 19 55

Juanita L. Lewis  
Notary Public.

My commission expires November 5, 1958

PLUGGING  
FILE SEC 34 T 29 R 16 W  
BOOK PAGE 18 LINE 15

NO. 2 BETZER

WELL RECORD

Location: App NW-NW NE, 34-29S-16W  
 Kiowa County, Kansas  
 Operator: Gramhart-Miller Oil Company  
 1005 East Second, Wichita, Kansas  
 Contractor: Graham-Messman-Rinehart Drilling Co.  
 1005 East Second, Wichita, Kansas  
 Casing Record: 8 5/8" @ 255' w/175 sacks cement

Commenced: November 2, 1955  
 Completed: November 19, 1955  
 Elevation: 1931 KB  
 Production: DEA

....L.O.O....

Shale	54
Red Bed	95
Sand	135
Red Bed	181
Gyp-Red Bed	257
Red Bed	785
Red Bed-Shale	1270
Shale-Shells	1585
Shale-Shells-Salt	2010
Lime-Shale	2170
Lime	2430
Lime-Shale	3302
Lime-Shale Streaks	3425
Lime-Shale	3651
Lime	4635
Cherty Lime	4676
Lime	4690
Lime-Chert	4774
Lime (Cherty)	4839
Lime	4851
Lime-Sand	4923
Sand	4958
Lime	4985 R.T.D.

Sample Tops:

Heebner 3872 (-1941)  
 Toronto 3887 (-1956)  
 Douglas 3926 (-1995)  
 Brn Lime 4034 (-2103)  
 Lansing 4050 (-2119)  
 Simpson 4857 (-2926)  
 Arbuckle 4956 (-3025)

The undersigned, GRAHAM-MESSMAN-RINEHART DRILLING COMPANY, hereby certifies that the above log is a true and correct log of the formation encountered in drilling the above well as reflected by the Daily Drilling Report.

RECEIVED  
 STATE CORPORATION COMMISSION

NOV 23 1955

CONSERVATION DIVISION  
 Wichita, Kansas

GRAHAM-MESSMAN-RINEHART DRILLING COMPANY

By: J. A. Gilliland  
 J. A. Gilliland

Subscribed and sworn to before me  
 this 22nd day of November 1955.

Frank L. Louis  
 Notary Public

My Commission Expires: November 5, 1958

PLUGGING  
 PER SEC 34Y 29 R 16 W  
 BOOK PAGE 18 LINE 15