


STATE OF KANSAS
STATE CORPORATION COMMISSION
CONSERVATION DIVISION
P. O. BOX 17027
WICHITA, KANSAS 67217

FORM CP-4

WELL PLUGGING RECORD

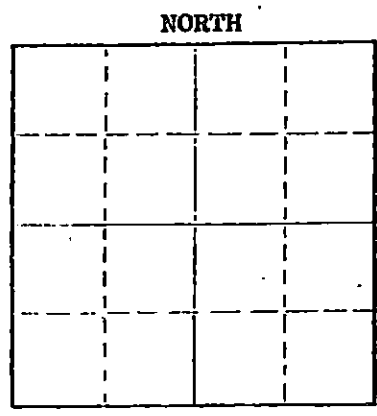

Locate well correctly on above Section Plat

Kiowa County, Sec. 34 Twp. 29S Rge. 16W (E) (W)

Location as "NE/CNW/SE/SW" or footage from lines SE NW
 Lease Owner Dunne-Gardner Petroleum, Inc.
 Lease Name Goldie Millar Well No. 1
 Office Address Suite 250, 200 West Douglas, Wichita, Kansas 67202
 Character of Well (completed as Oil, Gas or Dry Hole) Dry Hole
 Date well completed October 10, 1975
 Application for plugging filed October 10, 1975
 Application for plugging approved October 10, 1975
 Plugging commenced October 10, 1975
 Plugging completed October 10, 1975
 Reason for abandonment of well or producing formation _____

If a producing well is abandoned, date of last production _____ 19____
 Was permission obtained from the Conservation Division or its agents before plugging was commenced? Yes

Name of Conservation Agent who supervised plugging of this well Russell Bieberstein
 Producing formation _____ Depth to top _____ Bottom _____ Total Depth of Well 4710 Feet
 Show depth and thickness of all water, oil and gas formations.

OIL, GAS OR WATER RECORDS				CASING RECORD		
FORMATION	CONTENT	FROM	TO	SIZE	PUT IN	PULLED OUT
				8-5/8	259'	-

Describe in detail the manner in which the well was plugged, indicating where the mud fluid was placed and the method or methods used in introducing it into the hole. If cement or other plugs were used, state the character of same and depth placed, from _____ feet to _____ feet for each plug set.

Mud to 250', plug, 35 sx cement
 Mud to 40', plug, 1/4 hulls, 15 sx cement
 10 sx cement in rathole

RECEIVED
 STATE CORPORATION COMMISSION

OCT 16 1975 10-16-75

CONSERVATION DIVISION
 Wichita, Kansas

(If additional description is necessary, use BACK of this sheet)
 Name of Plugging Contractor _____
 Address _____

STATE OF KANSAS COUNTY OF SEDGWICK
Don Gardner (employee of owner) or (owner or operator) of the above-described

well, being first duly sworn on oath, says: That I have knowledge of the facts, statements, and matters herein contained and the log of the above-described well as filed and that the same are true and correct. So help me God.

(Signature) [Signature]
 Suite 250, 200 W. Douglas, Wichita, Kansas
 (Address)

Subscribed and Sworn to before me this 14th day of October 1975

My commission expires December 14, 1977
[Signature] Notary Public.

DRILLERS LOG

#1 GOLDIE MILLAR
SE NW Section 34-29S-16W
Kiowa County, Kansas

OPERATOR &
CONTRACTOR: Dunne-Gardner Petroleum, Inc.
Suite 250, 200 West Douglas
Wichita, Kansas 67202

COMMENCED: September 28, 1975

COMPLETED: October 10, 1975

CASING RECORD: 8-5/8" @ 259' w/200 sx

<u>FROM</u>	<u>TO</u>	<u>DESCRIPTION</u>
0	259	Clay, sand and shale
259	435	Shale
435	835	Shale and shells
835	860	Blaine
860	1130	Shale
1130	1635	Red bed and shale
1635	1985	Shale
1985	3885	Lime and shale
3885	4710	Lime
4710		Rotary total depth

RECEIVED
STATE CONSERVATION COMMISSION

OCT 16 1975

CONSERVATION DIVISION
Wichita, Kansas


STATE OF KANSAS)
) ss
COUNTY OF SEDGWICK)

I hereby certify that the above is a true and correct log, to the best of my knowledge and belief.


Don Gardner

Subscribed and sworn to before me this 14th day of October, 1975.

My commission expires:
December 14, 1977

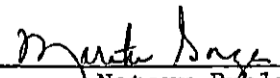
Notary Public