


STATE OF KANSAS
STATE CORPORATION COMMISSION

WELL PLUGGING RECORD

Give All Information Completely
Make Required Affidavit
Mail or Deliver Report to:
Conservation Division
State Corporation Commission
800 Bittling Building
Wichita, Kansas

Kiowa County, Sec. 34 Twp. 29 Rge. (E) 16 (W)

NORTH

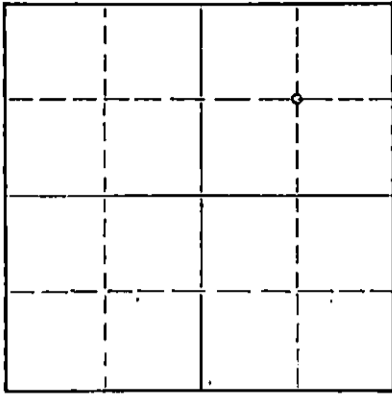

Locate well correctly on above
Section Plat

Location as "NE/CNW/SW" or footage from lines Center NE/4
Lease Owner Messman-Rinehart Oil Company
Lease Name Betzer Well No. 1
Office Address 518 Petroleum Building, Wichita, Kansas
Character of Well (completed as Oil, Gas or Dry Hole) Oil
Date well completed September 16 1955
Application for plugging filed December 3 1956
Application for plugging approved December 3 1956
Plugging commenced December 4 1956
Plugging completed December 10 1956
Reason for abandonment of well or producing formation
Well became non-productive
If a producing well is abandoned, date of last production November 28 1956
Was permission obtained from the Conservation Division or its agents before plugging was commenced? Yes

Name of Conservation Agent who supervised plugging of this well M. A. Rives
Producing formation Mississippi Depth to top 4632 Bottom 4647 Total Depth of Well 4665 Feet
Show depth and thickness of all water, oil and gas formations.

OIL, GAS OR WATER RECORDS

CASING RECORD

FORMATION	CONTENT	FROM	TO	SIZE	PUT IN	PULLED OUT
				8 5/8"	396	None
				5 1/2"	4665	2633'

Describe in detail the manner in which the well was plugged, indicating where the mud fluid was placed and the method or methods used in introducing it into the hole. If cement or other plugs were used, state the character of same and depth placed, from _____ feet to _____ feet for each plug set.

Plugged back with crushed rock to 4420', dumped 5 sax cement @ 4420' with dump bailer. Top of cement, 3385'. Pumped in 75 sacks Gel-Mud @ 1800' by Globe Cementing Co. Filled hole with mud to 350', set rock bridge, dumped 20 sax cement. Top of cement, 290'. Filled hole with mud to 35', set rock bridge dumped 10 sax cement for cap.

RECEIVED
STATE CORPORATION COMMISSION
DEC 13 1956
12-18-56
CONSERVATION DIVISION
Wichita, Kansas

Name of Plugging Contractor Miller Casing Pulling Company
Address P. O. Box 711, Great Bend, Kansas

STATE OF Kansas, COUNTY OF Sedgwick, ss.
J. A. Gilliland (employee of owner) or (owner or operator) of the above-described well, being first duly sworn on oath, says: That I have knowledge of the facts, statements, and matters herein contained and the log of the above-described well as filed and that the same are true and correct. So help me God.

(Signature) J. A. Gilliland
518 Petroleum Building, Wichita, Kans.
(Address)

SUBSCRIBED AND SWORN TO before me this 11th day of December, 1956

My commission expires September 5, 1960

Elaine M. Malone
Notary Public.

PLUGGING
FILE SEC 34 T 29 R 16 W
BOOK PAGE 121 LINE 19

NO. 1 BETZER

WELL RECORD

Location: Ctr NE/4, 34-29S-16W
Kiowa County, Kansas

Commenced: August 23, 1955

Operator: Gramehart-Miller Oil Company
1005 East Second, Wichita, Kansas

Completed: September 4, 1955

Elevation: 1922 KB

Contractor: Graham-Messman-Rinehart Drilling Company
1005 East Second, Wichita, Kansas

Production:

Casing Record: 8 5/8" @ 306' w/250 sacks cement
5 1/2" @ 4665' w/75 sacks cement

.....L O G.....

Red Bed-Clay	543
Red Bed-Shale	1490
Shale-Lime	2236
Lime-Shale	2416
Lime	2795
Lime-Shale	4162
Lime	4275
Lime	4493
Lime-Shale	4574
Core #1	4589
Core #2	4597
Chert	4665 R.T.D.

Sample Tops:

Heebner 3866 (-1944)
Douglas 3908 (-1986)
Brown Lime 4024 (-2102)
Lansing 4040 (-2118)
Cherokee Sd 4571 (-2649)
Mississippi 4595 (-2673)

The undersigned, GRAHAM-MESSMAN-RINEHART DRILLING COMPANY, hereby certifies that the above log is a true and correct log of the formation encountered in drilling the above well as reflected by the Daily Drilling Report.

GRAHAM-MESSMAN-RINEHART DRILLING COMPANY

BY:

J. A. Gilliland
J. A. Gilliland

Subscribed and sworn to before me
this 8th day of September 1955.

J. A. Gilliland
Notary Public

My Commission Expires: November 5, 1958

PLUGGING

FILE SEC. 34T. 29. R. 16W
BOOK PAGE 121 LINE 19

GMR

RECEIVED
NOTARY COMMISSION

DEC 18 1956

OBSERVATION DIVISION
Wichita, Kansas