


STATE OF KANSAS
STATE CORPORATION COMMISSION

Form CP-4

WELL PLUGGING RECORD

Give All Information Completely
Make Required Affidavit
Mail or Deliver Report to:
Conservation Division
State Corporation Commission
212 No. Market
Wichita, Kansas 67202

Kiowa County, Sec. 2 Twp. 29S Rge. 18W (E) (W)
Location as "NE/CNW/SW" or footage from lines 1470 W. of East Line & 1170 S. of North Line
Lease Owner Allen & Parker
Lease Name Schwarm Well No. 1
Office Address Box 906, Perryton, Texas 79070
Character of Well (completed as Oil, Gas or Dry Hole) Dry Hole
Date well completed _____ 19____
Application for plugging filed _____ 19____
Application for plugging approved 5-12-71 _____ 19____
Plugging commenced 5-12-71 at 7:00 A.M. _____ 19____
Plugging completed 5-12-71 _____ 19____
Reason for abandonment of well or producing formation Dry Hole

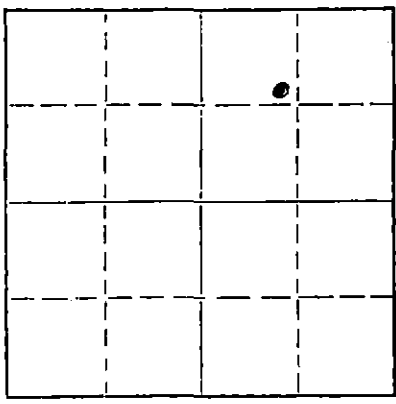

If a producing well is abandoned, date of last production _____ 19____
Was permission obtained from the Conservation Division or its agents before plugging was commenced? Yes

Name of Conservation Agent who supervised plugging of this well G. Russell Biberstein
Producing formation _____ Depth to top _____ Bottom _____ Total Depth of Well 4972 Feet
Show depth and thickness of all water, oil and gas formations.

OIL, GAS OR WATER RECORDS

CASING RECORD

FORMATION	CONTENT	FROM	TO	SIZE	PUT IN	PULLED OUT
Tertiary Sands	fresh water	40	185	8 5/8	386	None
Permian Carbonates	salt water	1855	4090			
Kansas City	Salt water	4300	4780			
Mississippi	Salt water	4894	4972			

Describe in detail the manner in which the well was plugged, indicating where the mud fluid was placed and the method or methods used in introducing it into the hole. If cement or other plugs were used, state the character of same and depth placed, from _____ feet to _____ feet for each plug set.

Drilling contractor layed down drill pipe and spotted 40 sxs cement with Halliburton @ 600'. Layed down 8 more joints and Halliburton spotted 30 sxs cement plug @ 370'. Finished P O H and spotted 15 sxs @ 40'. Put 2 sxs in rathole and 2 sxs in mousehole. Cut 8 5/8" off 4' below ground level and welded on cap.

RECEIVED
STATE CORPORATION COMMISSION
MAY 27 1971
CONSERVATION DIVISION
Wichita, Kansas

(If additional description is necessary, use BACK of this sheet)
Name of Plugging Contractor Halliburton Co.
Address Pratt, Kansas.

STATE OF Texas, COUNTY OF Ochiltree, ss.
Jack M. Allen (employee of owner) or (owner or operator) of the above-described well, being first duly sworn on oath, says: That I have knowledge of the facts, statements, and matters herein contained and the log of the above-described well as filed and that the same are true and correct. So help me God.

(Signature) [Signature]
Box 906, Perryton, Texas 79070 (Address)

SUBSCRIBED AND SWORN TO before me this 26th day of May, 19 71.

My commission expires June 1, 1971 [Signature] Notary Public.

WELL LOG

COMPANY **Allen & Parker**

SEC. **2** T. **29S** R. **18W**

FARM **Schwarn** NO. **1**


LOC. **SE/4**

TOTAL DEPTH **4972'**

COUNTY **Kiowa, Kansas**

COMM. **4-29-71** COMP. **5-12-71**

CONTRACTOR **Garvey Drilling Company**

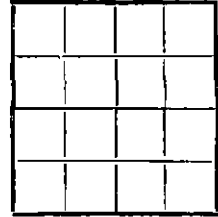

CASING

8 5/8" @ 395' w/325sz

ELEVATION

PRODUCTION **D & A**

FIGURES INDICATE BOTTOM OF FORMATIONS

100' Clay
 177' Sand
 395' Shale & Shells
 1150' Shale, Red Bed, & Shells
 1515' Shale
 1635' Shale & Lime
 2305' Lime & Shale
 3720' Shale & Lime
 3915' Lime & Shale
 4205' Shale & Lime
 4220' Lime & Shale
 4374' Lime
 4596' Lime & Shale
 4680' Lime
 4892' Lime & Shale
 4922' Chert
 4972' Lime & Chert
 4972' RTD

RECEIVED
 STATE CORPORATION COMMISSION
 MAY 27 1971
 CONSERVATION DIVISION
 RECEIVED
 STATE CORPORATION COMMISSION
 MAY 27 1971
 CONSERVATION DIVISION
 Wichita, Kansas

State of Kansas
 County of Barton } SS

I, Charlene Marker of Garvey Drilling Company
 upon oath state the above and foregoing is a true and correct copy of the log of the Schwarn No. 1 well.

Subscribed and sworn to before me this 18th day of May 19 71

My Commission Expires: July 8, 1974

Charlene Marker
[Signature]
 NOTARY PUBLIC