

STATE OF KANSAS
STATE CORPORATION COMMISSION

Form CP-4


WELL PLUGGING RECORD

Give All Information Completely
Make Required Affidavit
Mail or Deliver Report to:
Conservation Division
State Corporation Commission
211 No. Broadway
Wichita, Kansas

Kiowa County. Sec. 6 Twp. 29S Rge. 18W (E) (W)

Location as "NE/CNW/SW" or footage from lines SW SE
Lease Owner ALPINE OIL & ROYALTY CO., INC.
Lease Name Laura Graves Well No. 1
Office Address 800 Bitting Building, Wichita, Kansas
Character of Well (completed as Oil, Gas or Dry Hole) dry hole
Date well completed July 12, 1965 19
Application for plugging filed July 12, 1965 (phone) 19
Application for plugging approved July 12, 1965 (phone) 19
Plugging commenced July 12, 1965 19
Plugging completed July 12, 1965 19
Reason for abandonment of well or producing formation non-productive in commercial quantities
If a producing well is abandoned, date of last production _____ 19
Was permission obtained from the Conservation Division or its agents before plugging was commenced? yes

NORTH

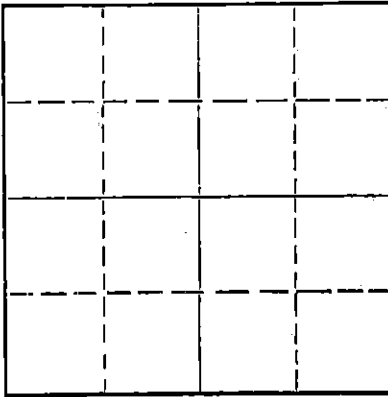

Locate well correctly on above Section Plat

Name of Conservation Agent who supervised plugging of this well A. Elving
Producing formation _____ Depth to top _____ Bottom _____ Total Depth of Well 5090 Feet
Show depth and thickness of all water, oil and gas formations.

OIL, GAS OR WATER RECORDS

CASING RECORD

FORMATION	CONTENT	FROM	TO	SIZE	PUT IN	PULLED OUT
				8 5/8"	323'	Cemented

Describe in detail the manner in which the well was plugged, indicating where the mud fluid was placed and the method or methods used in introducing it into the hole. If cement or other plugs were used, state the character of same and depth placed, from _____ feet to _____ feet for each plug set.

Filled hole with heavy mud from total depth to 300 feet. Set first plug at 300 feet with 1/4th sack hulls and 25 sacks cement. Filled hole with heavy mud to 40 feet. Set second plug at 40 feet with 1/4th sack hulls and 10 sacks cement. Plugged rat hole with 2 sacks cement.

RECEIVED
STATE CORPORATION COMMISSION
JUL 19 1965
CONSERVATION DIVISION
Wichita, Kansas
7-19-65

(If additional description is necessary, use BACK of this sheet)
Name of Plugging Contractor Gabbert-Jones, Inc.
Address 514 Orpheum Building, Wichita, Kansas

STATE OF Kansas, COUNTY OF Sedgwick, ss.
Dwight J. Wilson (employee of owner) or (owner or operator) of the above-described well, being first duly sworn on oath, says: That I have knowledge of the facts, statements, and-matters herein contained and the log of the above-described well as filed and that the same are true and correct. So help me God.

(Signature) Dwight J. Wilson
800 Bitting Building, Wichita, Kansas
(Address)

SUBSCRIBED AND SWORN TO before me this 16th day of July, 1965

My commission expires August 10, 1965

Virginia Mundell
Notary Public.

GABBERT-JONES, INC.
WICHITA, KANSAS
DRILLERS' WELL LOG

GRAVES #1
C SW SE SECTION 6-29S-18W
KIOWA COUNTY, KANSAS

COMMENCED: JUNE 28, 1965
COMPLETED: JULY 12, 1965

OPERATOR - ALPINE OIL & ROYALTY Co., INC.

DEPTH		FORMATION	REMARKS
FROM	TO		
0	105	CLAY	
105	200	SAND	
200	323	SAND AND SHALE	RAN 10 JOINTS 8-5/8" CASING, SET @ 323' w/250 SACKS CEMENT.
323	2220	SHALE	
2220	2515	SHALE AND SHELLS	
2515	2770	LIME	
2770	3505	LIME AND SHALE	
3505	3660	LIME	
3660	3750	SHALE AND LIME	
3750	4055	LIME	
4055	4185	LIME AND SHALE	
4185	4250	LIME	
4250	4275	LIME AND SHALE	
4275	4367	SHALE	
4367	4380	BROWN LIME	
4380	4405	LANSING-KANSAS CITY LIME	
4405	4761	LIME	
4761	4791	LIME-KANSAS CITY	
4791	4960	LIME AND SHALE	
4960	4985	LIME CHERT	
4985	5005	LIME	
5005	5090	LIME AND CHERT	
5090	TD		DRY AND ABANDONED.

RECEIVED
STATE CORPORATION COMMISSION

JUL 19 1965

CONSERVATION DIVISION
Wichita, Kansas

I, E. E. HALL, CERTIFY THIS IS A CORRECT COPY OF THE DRILLERS LOG FOR THE WELL DRILLED IN THE C SW SE SECTION 6-29S-18W, KIOWA COUNTY, KANSAS, TO THE BEST OF MY KNOWLEDGE AND BELIEF.




E. E. HALL

STATE OF KANSAS)
) SS
COUNTY OF SEDGWICK)

BEFORE ME, THE UNDERSIGNED, A NOTARY PUBLIC WITHIN AND FOR SAID COUNTY AND STATE, ON THIS 15TH DAY OF JULY, 1965, PERSONALLY APPEARED E. E. HALL, TO ME PERSONALLY KNOWN TO BE THE IDENTICAL PERSON WHO EXECUTED THE WITHIN AND FOREGOING INSTRUMENT AND ACKNOWLEDGED TO ME THAT HE EXECUTED THE SAME AS HIS FREE AND VOLUNTARY ACT AND DEED FOR THE USES AND PURPOSES THEREIN SET FORTH.

IN WITNESS WHEREOF, I HAVE HEREUNTO SET MY HAND AND OFFICIAL SEAL THE DAY AND YEAR LAST ABOVE WRITTEN.

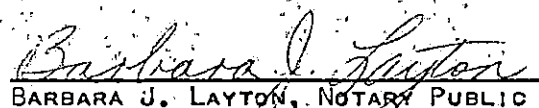
BARBARA J. LAYTON, NOTARY PUBLIC

MY COMMISSION EXPIRES FEBRUARY 1, 1968.