


STATE OF KANSAS
STATE CORPORATION COMMISSION

Form CP-4

Give All Information Completely
Make Required Affidavit
Mail or Deliver Report to:
Conservation Division
State Corporation Commission
212 No. Market
Wichita, Kansas 67202

WELL PLUGGING RECORD

Kiowa County. Sec. 28 Twp. 29 Rge. (E) 18 (W)
Location as "NE/CNW/SW" or footage from lines C SE SE
Lease Owner Misco Supply Company
Lease Name Mary Schmidt Well No. 4
Office Address 257 N. Broadway, Wichita, Kansas
Character of Well (completed as Oil, Gas or Dry Hole) oil
Date well completed _____ 19____
Application for plugging filed June 15 1971
Application for plugging approved _____ 19____
Plugging commenced July 22 1971
Plugging completed August 12 1971
Reason for abandonment of well or producing formation depleted

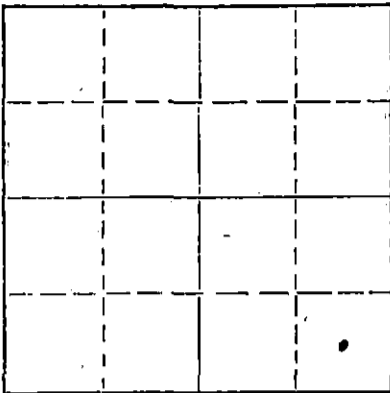

Locate well correctly on above
Section Plot

If a producing well is abandoned, date of last production _____ 19____
Was permission obtained from the Conservation Division or its agents before plugging was commenced? yes

Name of Conservation Agent who supervised plugging of this well G. R. Biberstein
Producing formation _____ Depth to top _____ Bottom _____ Total Depth of Well 5070 Feet
Show depth and thickness of all water, oil and gas formations.

OIL, GAS OR WATER RECORDS

CASING RECORD

FORMATION	CONTENT	FROM	TO	SIZE	PUT IN	PULLED OUT
		0	400'	8 5/8"	400'	none
		0	5065'	5 1/2"	5065'	3822.60

Describe in detail the manner in which the well was plugged, indicating where the mud fluid was placed and the method or methods used in introducing it into the hole. If cement or other plugs were used, state the character of same and depth placed, from _____ feet to _____ feet for each plug set.

Sanded back to 4900' and dumped 5 sacks of cement.

Set 20' rock bridge at 260'. Plug well with 4 yards of ready mix cement.

RECEIVED
STATE CORPORATION COMMISSION
SEP 2 1971
CONSERVATION DIVISION
Wichita, Kansas
9-2-71

(If additional description is necessary, use BACK of this sheet)
Name of Plugging Contractor PIPE PULLERS, INC.
Address Box 486, Ellinwood, Kansas

STATE OF KANSAS, COUNTY OF BARTON, ss.
Evelyn Roth (employee of owner) or (~~owner or operator~~) of the above-described well, being first duly sworn on oath, says: That I have knowledge of the facts, statements, and matters herein contained and the log of the above-described well as filed and that the same are true and correct. So help me God.

(Signature) Evelyn Roth
Ellinwood, Kansas (Address)

SUBSCRIBED AND SWORN TO before me this 30th day of August, 1971

My commission expires Feb. 10, 1975

George A. Meyer (Notary Public)

WELL LOG BUREAU—KANSAS GEOLOGICAL SOCIETY
503 East Murdock, Wichita, Kansas


COPY

GULF OIL CORP, FALCON SEABOARD DRG., CO.
Company. & SINCLAIR OIL & GAS CO.
Farm. Mary Schmidt No. 4

SEC. 28 T. 29 R. 18W
C SE SE
651.8' WEL, 660' NSL

Total Depth. 5070 PB 5029
Comm. 12-18-56 Comp. 1-4-57
Shot or Treated.
Contractor.
Issued. 3-9-57

County Kiowa
KANSAS

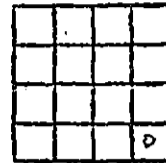

Elevation. 2215 DF

Production. 279 BOPD, No water,

Figures indicate Bottom of Formations. 60.211 MCF gas

clay	35
clay, red bed	401
red bed, shale	2008
lime, shale	2308
lime	2520
lime, shale	2660
lime	2814
shale, lime	2946
lime	3023
lime, shale	4405
lime	4906
lime, chert	4975
chert	5019
chert, lime	5065
lime	5070
Total Depth	PB 5029

Tops:

Heebner shale	4142
Douglas group	4174
Lansing-Kansas City	4331
Mississippian chert	4937
Mississippian lime	5053

Perf. 4973-78 w/1-3/4" swing
jets. Acidized w/250 gallons mud
acid.

Distance "H" - 12.59' from RKB to top
of 8 5/8" OD

State Pot. Physical: 1-22-57
Flowed 93 BO, no wtr, thru
20/64" choke in 8 hrs.
Allowable 74 BOPD, Gravity of
oil GOR 216

RECEIVED
STATE CORPORATION COMMISSION
JUN 17 1971
CONSERVATION DIVISION
Wichita, Kansas