


STATE OF KANSAS
STATE CORPORATION COMMISSION

WELL PLUGGING RECORD

Give All Information Completely
Make Required Affidavit
Mail or Deliver Report to:
Conservation Division
State Corporation Commission
800 Biting Building
Wichita, Kansas

Kiowa County. Sec. 28 Twp. 29S Rge. 18W 1870

Location as "NE/CNW/SW" or footage from lines C NE NE
Lease Owner Gulf Oil Corporation
Lease Name Mary Schmidt Well No. 3*
Office Address Box 661, Tulsa, Oklahoma
Character of Well (completed as Oil, Gas or Dry Hole) Dry Hole*
Date well completed 8-18 19 56
Application for plugging filed 8-22 19 56
Application for plugging approved 8-24 19 56
Plugging commenced 10-2 19 56
Plugging completed 10-2 19 56
Reason for abandonment of well or producing formation Dry hole*

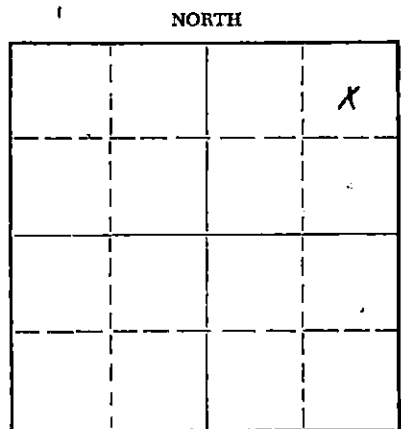

Locate well correctly on above
Section Plat

If a producing well is abandoned, date of last production --- 19 ---
Was permission obtained from the Conservation Division or its agents before plugging was commenced? Yes

Name of Conservation Agent who supervised plugging of this well M. A. Rives
Producing formation Dry Hole Depth to top --- Bottom --- Total Depth of Well 1026 Feet
Show depth and thickness of all water, oil and gas formations.

OIL, GAS OR WATER RECORDS

CASING RECORD

FORMATION	CONTENT	FROM	TO	SIZE	PUT IN	PULLED OUT
				8-5/8"	369	- 0 -

Describe in detail the manner in which the well was plugged, indicating where the mud fluid was placed and the method or methods used in introducing it into the hole. If cement or other plugs were used, state the character of same and depth placed, from --- feet to --- feet for each plug set.
Filled hole with mud. Pumped 100 sacks cement into surface casing filling hole into cellar.

*Hole was drilled to 1026'. 8-5/8" casing was set at 369'. When cement had set it was found that the bottom joint of casing had slipped to one side of string. Tried to fish, but position of casing joint made it impossible. Rig was skidded 19' South and 5' East of this location and new hole was spudded. New hole carries the same name and number as this hole. Attached is well formation record which was not available at time application was made.

(If additional description is necessary, use BACK of this sheet)

Name of Plugging Contractor Halliburton Oil Well Cementing Company
Address Great Bend, Kansas

STATE OF Kansas, COUNTY OF Sedgwick, ss.
T. A. Trax (employee of owner) or (owner) of the above-described well, being first duly sworn on oath, says: That I have knowledge of the facts, statements, and matters herein contained and the log of the above-described well as filed and that the same are true and correct. So help me God.

(Signature) T. A. Trax
Box 2233, Wichita, Kansas
(Address)

SUBSCRIBED AND SWORN TO before me this 4th day of October, 19 56

My commission expires 2-4-59

Ray W. Rouer
RECEIVED
CORPORATION COMMISSION
OCT 24 1956
10-9-56
Notary Public.

JRM:BJT
10-4-56

PLUGGING
FILE SEC 28 T. 29 R. 18W
BOOK PAGE 92 LINE 42

WELL LOG

(First Run)

COMPANY: GULF OIL CORPORATION

Sec. 28-29S-18W

FARM: Mary Schmidt No. 3

Loc. C NE NE

TOTAL DEPTH - 1026'

County - Kiowa

COMM: 8-16-56. COMP: 8-19-56.

CASING

ELEVATION

8-5/8" - 369'

D.F. -

Gr. -

DRILLER'S LOG

Red Bed	0	66
Red Bed & Shells	66	815
Red Bed & Shale	815	1026
Total Depth		1026

PLUGGING
 FILE SEC 28 T 29 R 18W
 BOOK PAGE 92 LINE 42

RECEIVED
 STATE CORPORATION COMMISSION
 OCT 21 1956
 CONSERVATION DIVISION
 Wichita, Kansas