


STATE OF KANSAS  
STATE CORPORATION COMMISSION

WELL PLUGGING RECORD

Give All Information Completely  
Make Required Affidavit  
Mail or Deliver Report to  
Conservation Division  
State Corporation Comm.  
245 North Water  
Wichita, KS 67202

Kiowa County. Sec. 20 Twp. 29 Rge. 17W E/W  
Location as "NE/CNW $\frac{1}{4}$ SW $\frac{1}{4}$ " or footage from lines  
SE SE  
Lease Owner Cherokee Resources  
Lease Name Cronic Well No. 1  
Office Address 432 Mayo Bldg., Tulsa, Okla. 74103  
Character of Well (Completed as Oil, Gas or Dry Hole)  
Dry Hole

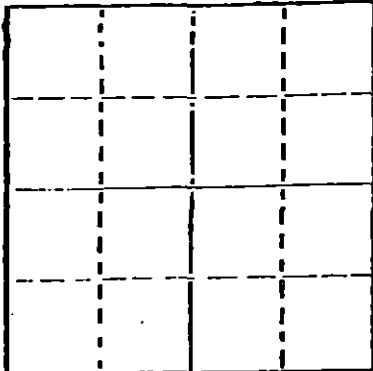

Locate well correctly on above  
Section Plat

Date Well completed 4-15 1976  
Application for plugging filed 4-15 1976  
Application for plugging approved 4-15 1976  
Plugging commenced 4-15 1976  
Plugging completed 4-15 1976  
Reason for abandonment of well or producing formation  
No commercial quantities of oil or gas encountered  
If a producing well is abandoned, date of last production  
19  
Was permission obtained from the Conservation Division or  
its agents before plugging was commenced? Yes

Name of Conservation Agent who supervised plugging of this well G. R. Biberstein  
Producing formation \_\_\_\_\_ Depth to top \_\_\_\_\_ Bottom \_\_\_\_\_ Total Depth of Well 4885  
Show depth and thickness of all water, oil and gas formations.

OIL, GAS OR WATER RECORDS

CASING RECORD

FORMATION	CONTENT	FRESH	TD	SIZE	PUT IN	PULLED OUT
Surface Hole	Shale	Surf.	311	8-5/8"	303	None

Describe in detail the manner in which the well was plugged, indicating where the mud fluid was placed and the method or methods used in introducing it into the hold. If cement or other plugs were used, state the character of same and depth placed, from \_\_\_\_\_ feet to \_\_\_\_\_ feet for each plug set.

Fluid to 300', plug, 40 sx cement;  
Fluid to 40', plug, 15 sx cement;  
Five sacks cement in rat hole.

RECEIVED  
STATE CORPORATION COMMISSION

APR 23 1976

CONSERVATION DIVISION  
Wichita, Kansas

4-23-76

(If additional description is necessary, use BACK of this sheet)

Name of Plugging Contractor D N B DRILLING, INC.  
701 First National Building  
Wichita, Kansas 67202

STATE OF KANSAS COUNTY OF \_\_\_\_\_  
JAMES L. DONELSON (employee of owner) or (owner or operator) of the above-described well, being first duly sworn on oath, says: That I have knowledge of the facts, statements, and matters herein contained and the log of the above-described well as filed and that the same are true and correct. So help me God.

(Signature) *James L. Donelson*  
701 First Nat'l Bldg., Wichita, Ks.  
(Address)

SUBSCRIBED AND SWORN TO before me this 22nd day of April 1976

My commission expires 8-25-76

Ella Priess Notary Public

Ella Priess  
STATE NOTARY PUBLIC  
Sedgwick County, Kansas  
My Com. Expires Aug. 25, 1976

DRILLERS LOG

CHEROKEE RESOURCES  
432 Mayo Building  
Tulsa, Okla. 74103

No. 1 Cronie  
SE SE, Sec. 20-29S-17W  
Kiowa County, Kansas

Elev: 2128 K.B.

Commenced: 4-6-76  
Completed: 4-15-76

Surface Casing: 303' of  
8-5/8" cemented w/200 ex  
common cement, 2% Gel, 3% cc.  
4-6-76

FORMATION

DEPTH

Surface Hole	0 - 311
Red Bed & Shale	311 - 1300
Shale & Lime	1300 - 2350
Lime & Shale	2350 - 2900
Shale	2900 - 3300
Lime & Shale	3300 - 3510
Shale & Lime	3510 - 3988
Lime & Shale	3988 - 4490
Lime	4490 - 4640
Lime & Shale	4640 - 4740
Shale	4740 - 4850
Cherty Lime	4850 - 4860
Shale & Lime	4860 - 4872
Lime	4872 - 4885 RTD

I do hereby certify that the foregoing statements are true and correct to the best of my knowledge and belief.

D. N. B. DRILLING, INC.

*James L. Donelson*  
JAMES L. DONELSON

RECEIVED  
STATE OF KANSAS  
COMMISSION

APR 23 1976

COMMISSION DIVISION  
Tulsa, Oklahoma

STATE OF KANSAS: ss:

Subscribed and sworn to before me this 22nd day of April 1976.

*Ella Priess*  
Ella Priess, Notary Public

*Ella Priess*  
STATE NOTARY PUBLIC  
Sedgwick County, Kansas  
My Com. Expires Aug. 25, 1976