

STATE OF KANSAS
STATE CORPORATION COMMISSION

WELL PLUGGING RECORD

Give All Information Completely
Make Required Affidavit
Mail or Deliver Report to
Conservation Division
State Corporation Comm.
245 North Water
Wichita, KS 67202

Kiowa County, Sec. 1 Twp. 29S Rge. 16W /E/W
Location as "NE/CNW $\frac{1}{4}$ SW $\frac{1}{4}$ " or footage from lines
C S/2 NE/4 SW/4


Lease Owner Imperial Oil Company
Lease Name Starkey Well No. 1-1
Office Address 720 Fourth Financial Center, Wichita, Ks.
Character of Well (Completed as Oil, Gas or Dry Hole) D & A

Date Well completed November 16, 1979
Application for plugging filed November 16, 1979
Application for plugging approved November 16, 1979
Plugging commenced November 16, 1979
Plugging completed November 16, 1979
Reason for abandonment of well or producing formation D & A

If a producing well is abandoned, date of last production 19

Was permission obtained from the Conservation Division or its agents before plugging was commenced? Yes

Name of Conservation Agent who supervised plugging of this well Wm. T. Owen
Producing formation Depth to top Bottom Total Depth of Well 4,730
Show depth and thickness of all water, oil and gas formations.

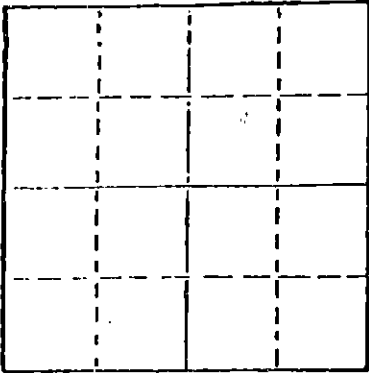

Locate well correctly on above Section Plot

OIL, GAS OR WATER RECORDS

CASING RECORD

FORMATION	CONTENT	FROM	TO	SIZE	PUT IN	PULLED OUT
				8 5/8"	406'	-0-

Describe in detail the manner in which the well was plugged, indicating where the mud fluid was placed and the method or methods used in introducing it into the hold. If cement or other plugs were used, state the character of same and depth placed, from feet to feet for each plug set.

Plug #1 @ 390' w/50 sx cement
Plug #2 @ 40' w/10 sx cement
5 sx cement in rathole

11-28-79

RECEIVED
STATE CORPORATION COMMISSION

(If additional description is necessary, use BACK of this sheet) NOV 28 1979

Name of Plugging Contractor Red Tiger Drilling Company
1720 KSB&T Building, Wichita, Kansas 67202
CONSERVATION DIVISION
Wichita, Kansas

STATE OF Kansas COUNTY OF Sedgwick, ss. contractor
Gloria Fawcett (employee of ~~xxxxxx~~)


of the above-described well, being first duly sworn on oath, says: That I have knowledge of the facts, statements, and matters herein contained and the log of the above-described well as filed and that the same are true and correct. So help me God.

(Signature) Gloria Fawcett
1720 KSB&T Building, Wichita, Kansas 67202
(Address)

SUBSCRIBED AND SWORN TO before me this 26th day of November, 1979.

Joyce A. Hagermann
Notary Public.

My commission expires

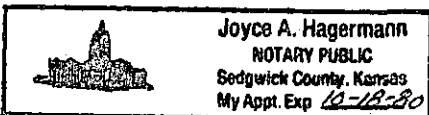

DRILLERS LOG

No. 1-1 Starkey

CASING RECORD:
8 5/8" @ 406'
w/275 sx cement

COMPANY: Imperial Oil Company
CONTRACTOR: Red Tiger Drilling Company
COMMENCED: November 4, 1979
COMPLETED: November 16, 1979

DESCRIPTION:
C S/2 NE/4 SW/4
Sec. 1-T29S-R16W
Kiowa County, Kansas

TOTAL DEPTH: 4,730'

ELEVATION: 2,050' KB

<u>FORMATION</u>	<u>FROM</u>	<u>TO</u>	<u>REMARKS</u>
Sand & Red Bed	0	265	
Red Bed	265	408	
Sand	408	425	
Sand & Shale	425	1100	
Shale	1100	1710	
Shale & Lime	1710	2185	
Lime	2185	2290	
Lime & Shale	2290	2435	
Lime	2435	3735	
Lime & Shale	3735	3935	
Lime	3935	4730	
RTD		4730	

I certify that this is a true and correct copy of the above log to the best of my knowledge.

RED TIGER DRILLING COMPANY

Gloria Fawcett
Gloria Fawcett

Subscribed and sworn to before me this 26th day of November, 1979.

Joyce A. Hagermann
Notary Public

RECEIVED
STATE CORPORATION COMMISSION

NOV 28 1979

CONSERVATION DIVISION
Wichita, Kansas

