


STATE OF KANSAS  
STATE CORPORATION COMMISSION

WELL PLUGGING RECORD

Give All Information Completely  
Make Required Affidavit  
Mail or Deliver Report to:  
Conservation Division  
State Corporation Commission  
800 Bittling Building  
Wichita, Kansas

Kiowa County. Sec. 18 Twp. 29S Rge. (E) 18 (W)  
Location as "NE/CNW/SW" or footage from lines 1320' SNL and 1320' EWL  
Lease Owner Gulf Oil Corporation  
Lease Name M. Monroe Well No. 1  
Office Address Box 661, Tulsa, Oklahoma  
Character of Well (completed as Oil, Gas or Dry Hole) Dry Hole  
Date well completed 4-11 19 56  
Application for plugging filed 4-13 19 56  
Application for plugging approved 4-12 19 56  
Plugging commenced 4-12 19 56  
Plugging completed 4-12 19 56  
Reason for abandonment of well or producing formation Dry Hole

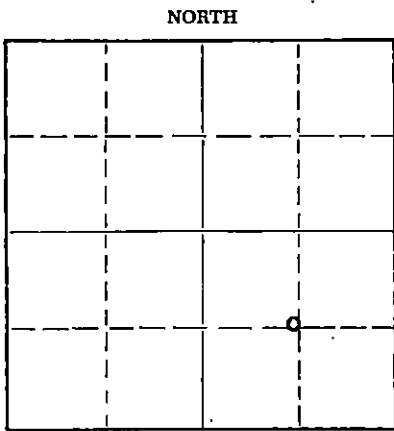

Locate well correctly on above Section Flat

If a producing well is abandoned, date of last production -- 19 --  
Was permission obtained from the Conservation Division or its agents before plugging was commenced? Yes

Name of Conservation Agent who supervised plugging of this well M. O. Rives  
Producing formation -- Depth to top -- Bottom -- Total Depth of Well 5124 Feet  
Show depth and thickness of all water, oil and gas formations.

OIL, GAS OR WATER RECORDS

CASING RECORD

FORMATION	CONTENT	FROM	TO	SIZE	PUT IN	PULLED OUT
				8-5/8"	362'	-0-

Describe in detail the manner in which the well was plugged, indicating where the mud fluid was placed and the method or methods used in introducing it into the hole. If cement or other plugs were used, state the character of same and depth placed, from                      feet to                      feet for each plug set.

Filled hole with heavy mud to 350' of surface. Spotted 1/2 sack hulls and HOWCO wood plug at 350'. Spotted through drill pipe 35 sacks cement on plug. Filled hole to 35' of surface with mud. Set HOWCO wood plug and 1/4 sack hulls and capped with 15 sacks cement filling hole into cellar.

(If additional description is necessary, use BACK of this sheet)

Name of Plugging Contractor Falcon-Seaboard Drilling Co.  
Address East Mezzanine, Stanolind Building, Tulsa, Oklahoma

STATE OF Kansas, COUNTY OF Barton, ss. W. H. Duley (employee of owner) or Notary Public of the above-described well, being first duly sworn on oath, says: That I have knowledge of the facts, statements, and matters herein contained and the log of the above-described well as filed and that the same are true and correct. So help me God.

(Signature) W. H. Duley  
Box 225, Great Bend, Kansas  
(Address)

SUBSCRIBED AND SWORN to before me this 13th day of April, 19 56

My commission expires October 26, 1959

RECEIVED Notary Public.  
STATE CORPORATION COMMISSION

:BNG  
4-13-56

**PLUGGING**  
FILE SEC 18 T 29 R 18W  
BOOK PAGE 53 LINE 36

APR 14 1956  
CONSERVATION DIVISION  
Wichita, Kansas  
4-14-56