


STATE OF KANSAS
STATE CORPORATION COMMISSION

Give All Information Completely
Make Required Affidavit
Mail or Deliver Report to:
Conservation Division
State Corporation Commission
211 No. Broadway
Wichita, Kansas

WELL PLUGGING RECORD

Kingman County. Sec. 10 Twp. 29S Rge. 9W (E) (W)
Location as "NE/CNW/SW" or footage from lines SW SW SW
Lease Owner M & L Oil Company
Lease Name Peter Henning Well No. 1
Office Address 211 Brown Bldg., Wichita, Kansas
Character of Well (completed as Oil, Gas or Dry Hole) Dry Hole
Date well completed December 23 1956
Application for plugging filed December 24 1956
Application for plugging approved December 24 1956
Plugging commenced December 24 1956
Plugging completed December 24 1956
Reason for abandonment of well or producing formation Dry Hole

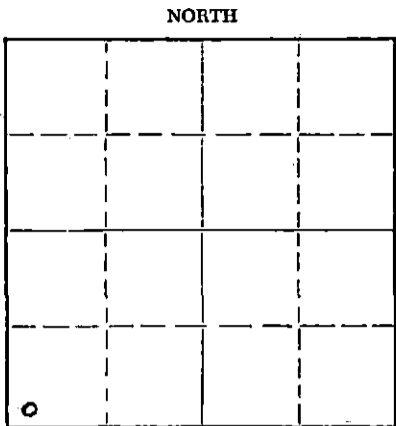

Locate well correctly on above
Section Plat

If a producing well is abandoned, date of last production _____ 19____
Was permission obtained from the Conservation Division or its agents before plugging was commenced? Yes

Name of Conservation Agent who supervised plugging of this well M. A. Rives
Producing formation _____ Depth to top _____ Bottom _____ Total Depth of Well 4502 Feet
Show depth and thickness of all water, oil and gas formations.

OIL, GAS OR WATER RECORDS

CASING RECORD

FORMATION	CONTENT	FROM	TO	SIZE	PUT IN	PULLED OUT
				8-5/8"	187'	

Describe in detail the manner in which the well was plugged, indicating where the mud fluid was placed and the method or methods used in introducing it into the hole. If cement or other plugs were used, state the character of same and depth placed, from _____ feet to _____ feet for each plug set.

Filled hole with mud to 135'. Set bottom plug @ 135' with 1/4 sack hulls on top of plug. 15 sacks cement through drill pipe. Filled hole to 20'. Set top plug @ 20' with 1/4 sack hulls on top of plug. Dumped 5 sacks cement. Cemented to bottom of cellar. Completed 2:00 a.m. 12/24/56.

RECEIVED
STATE CORPORATION COMMISSION

DEC 23 1956

12-28-56

CONSERVATION DIVISION

(If additional description is necessary, use BACK of this sheet)

Name of Plugging Contractor Anschutz Drilling Co., Inc.
Address 709 Union Natl. Bldg., Wichita, Kansas

STATE OF Kansas, COUNTY OF Sedgwick, ss.
Shirley Salley (employee of owner) or (owner or operator) of the above-described well, being first duly sworn on oath, says: That I have knowledge of the facts, statements, and matters herein contained and the log of the above-described well as filed and that the same are true and correct. So help me God.

(Signature) Shirley Salley
709 Union Natl. Bldg., Wichita, Kansas
(Address)

SUBSCRIBED AND SWORN TO before me this 27th day of December 1956
Kenneth R. Swenson
Kenneth R. Swenson Notary Public.

My commission expires April 27, 1959

PLUGGING
FILED DEC 26 10 29 AM '56
BOOK PAGE 128 L' E 37

M & L OIL COMPANY
 #1 PETER HENNING
 SW SW SW Sec. 10-29S-9W
 Kingman County, Kansas

FROM	TO	
0	120	Sand and shells
120	190	Red rock
190	700	Shale and red bed
700	1350	Shale
1350	1500	Shale with lime
1500	1650	Lime and shale
1650	1745	Lime
1745	2025	Lime and shale
2025	2130	Lime
2130	2695	Shale and lime
2695	2790	Lime and shale
2790	2990	Shale and lime
2990	3545	Lime and shale
3545	3610	Shale and lime
2610	3886	Lime
3886	3930	Lime and shale
3930	4000	Lime
4000	4055	Lime and shale
4055	4096	Shale and lime
4096	4207	Lime and shale
4207	4275	Mississippi lime
4275	4293	Lime
4293	4349	Lime and shale
4349	4403	Kinderhook shale
4403	4500	Shale
4500	4502	Viola
	4502	RTD

COMMENCED: 12/11/56

COMPLETED: 12/24/56

CASING RECORD:

Set 187' of 8-5/8" surface casing with 125 sacks cement, 200# calcium chloride, 200# jell.

STATE OF KANSAS)
) SS
 COUNTY OF SEDGWICK)

I hereby affirm that the above and foregoing is a true and correct copy of the formations encountered on the #1 Peter Henning, SW SW SW of Section 10-29S-9W, Kingman County, Kansas, as reflected by the daily drilling reports.

ANSCHUTZ DRILLING CO., INC.

By: *Shirley Salley*
 Shirley Salley

Subscribed and sworn to before me this 26th day of December, 1956.

My Commission Expires: April 27, 1959

Kenneth R. Swenson
 Kenneth R. Swenson, Notary Public
RECEIVED
 STATE CORPORATION COMMISSION

DEC 23 1956

CONSERVATION DIVISION
 Wichita, Kansas

PLUGGING
 FILE SEC 10 T 29 R 9 W
 BOOK PAGE 128 LINE 37