


STATE OF KANSAS
STATE CORPORATION COMMISSION

Give All Information Completely
Make Required Affidavit
Mail or Deliver Report to:
Conservation Division
State Corporation Commission
211 No. Broadway
Wichita, Kansas

WELL PLUGGING RECORD

NORTH

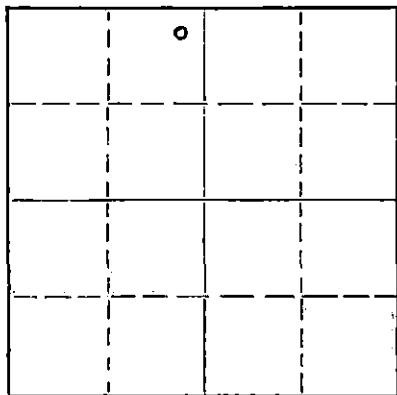

Locate well correctly on above
Section Plat

Kingman County. Sec. 15 Twp. 29S Rge. 9W (E) (W)
Location as "NE/CNW/SW" or footage from lines NE NE NW
Lease Owner Anschutz Drilling Co., Inc.
Lease Name Hageman Well No. 4
Office Address 709 Union Natl. Bldg., Wichita, Kansas
Character of Well (completed as Oil, Gas or Dry Hole) Dry Hole
Date well completed January 9 19 57
Application for plugging filed January 9 19 57
Application for plugging approved January 9 19 57
Plugging commenced January 9 19 57
Plugging completed January 9 19 57
Reason for abandonment of well or producing formation Dry

If a producing well is abandoned, date of last production _____ 19____
Was permission obtained from the Conservation Division or its agents before plugging was commenced? Yes

Name of Conservation Agent who supervised plugging of this well M. A. Rives
Producing formation _____ Depth to top _____ Bottom _____ Total Depth of Well 4493 Feet
Show depth and thickness of all water, oil and gas formations.

OIL, GAS OR WATER RECORDS

CASING RECORD

FORMATION	CONTENT	FROM	TO	SIZE	PUT IN	PULLED OUT
				8-5/8"	209'	

Describe in detail the manner in which the well was plugged, indicating where the mud fluid was placed and the method or methods used in introducing it into the hole. If cement or other plugs were used, state the character of same and depth placed, from _____ feet to _____ feet for each plug set.

Bottom plug at 200' with 1/4 sack hulls, 20 sacks cement.
Top plug at 35', swung on wire, with 10 sacks cement.

(If additional description is necessary, use BACK of this sheet)

Name of Plugging Contractor Anschutz Drilling Co., Inc.
Address 709 Union Natl. Bldg., Wichita, Kansas

STATE OF Kansas, COUNTY OF Sedgwick, ss.
Shirley Salley (employee of owner) or (owner or operator) of the above-described well, being first duly sworn on oath, says: That I have knowledge of the facts, statements, and matters herein contained and the log of the above-described well as filed and that the same are true and correct. So help me God.

(Signature) Shirley Salley
709 Union Natl. Bldg., Wichita, Kansas
(Address)

SUBSCRIBED AND SWORN TO before me this 14th day of January, 19 57
Kenneth R. [Signature]
Notary Public.

My commission expires April 27, 1959

RECEIVED
STATE CORPORATION COMMISSION

JAN 16 1957
1-16-57
CONSERVATION DIVISION
Wichita, Kansas

PLUGGING
FILE SEC 15 T. 29 R. 9W
BOOK PAGE 132 LINE 40

DRILLERS' LOG

ANSCHUTZ DRILLING CO., INC. #4 HAGEMAN
NE NE NW Sec. 15-29S-9W
Kingman County, Kansas

FROM	TO	
0	60	Soil, sand and gravel
60	90	Shale and shells
90	214	Red rock
214	390	Shale and shells
390	785	Shale and red bed
785	805	Anhydrite
805	1100	Shale
1100	1170	Salt
1170	1360	Shale with lime
1360	1545	Lime and shale
1545	1795	Lime
1795	3610	Lime and shale
3610	3670	Lime
3670	3979	Lime
3979	4190	Lime and shale
4190	4206	Mississippi
4206	4240	Mississippi chert
4240	4256	Mississippi lime
4256	4275	Mississippi lime - hard
4275	4309	Lime
4309	4367	Lime and shale
4367	4429	Shale with lime
4429	4477	Lime and shale
4477	4489	Shale
4489	4493	Viola
	4493	Total Depth

COMMENCED: 12/26/56

COMPLETED: 1/9/57

CASING RECORD:

Set 209' of 8-5/8" surface casing with 135 sacks cement, 200# calcium chloride, 200# jell.

STATE OF KANSAS)
) SS
COUNTY OF SEDGWICK)

I hereby affirm that the above and foregoing is a true and correct copy of the formations encountered on the #4 Hageman, NE NE NW of Section 15-29S-9W, Kingman County, Kansas, as reflected by the daily drilling reports.

ANSCHUTZ DRILLING CO., INC.

By: *Shirley Salley*
Shirley Salley

Subscribed and sworn to before me this 15th day of January, 1957.

My Commission Expires: April 27, 1959

Kenneth R. Swenson
Kenneth R. Swenson, Notary Public

PLUGGING
FILE SEC 15 T. 29 R. 9W
BOOK PAGE 132 L. 40

RECEIVED
STATE CORPORATION COMMISSION

JAN 16 1957

CONSERVATION DIVISION
Wichita, Kansas