


Give All Information Completely
Make Required Affidavit
Mail or Deliver Report to:
Conservation Division
State Corporation Commission
211 No. Broadway
Wichita, Kansas

WELL PLUGGING RECORD

Kingman County, Sec. 15 Twp. 29 Rge. 9 W (E) (W)
Location as "NE/CNWxSWx" or footage from lines 330 so & 330 west of n e corner
Lease Owner Mahoney Drilling Co.
Lease Name Hageman Well No. 3
Office Address Box 1257 Liberal, Kansas
Character of Well (completed as Oil, Gas or Dry Hole) Oil
Date well completed 11 - 16 19 54
Application for plugging filed 3 - 29 19 67
Application for plugging approved 4 - 1 19 67
Plugging commenced 4 - 8 19 67
Plugging completed 4 - 11 19 67
Reason for abandonment of well or producing formation Too much water

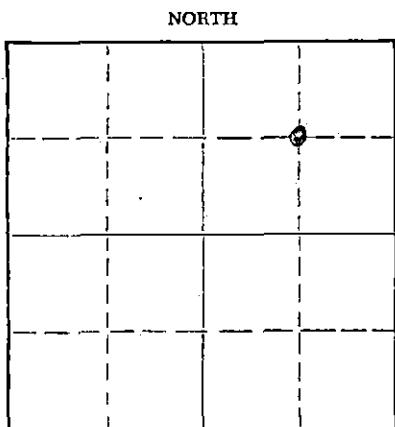

Locate well correctly on above Section Plat

If a producing well is abandoned, date of last production 19
Was permission obtained from the Conservation Division or its agents before plugging was commenced? Yes

Name of Conservation Agent who supervised plugging of this well Archie Elving
Producing formation Depth to top 4483 Bottom 4491 Total Depth of Well 4513 Feet
Show depth and thickness of all water, oil and gas formations.

OIL, GAS OR WATER RECORDS

CASING RECORD

FORMATION	CONTENT	FROM	TO	SIZE	PUT IN	PULLED OUT
				8 5/8	313	0
				5 1/2	4513	2 3018

Describe in detail the manner in which the well was plugged, indicating where the mud fluid was placed and the method or methods used in introducing it into the hole. If cement or other plugs were used, state the character of same and depth placed, from feet to feet for each plug set.

Mix 12 sacks cement to plug off perforations at 4483 feet. Stop plug at 3800 feet. Shoot pipe loose at 3018 feet and lay down same. Ten foot bridge at 260 to 250. Put 30 sacks cement at 250 to 150. Mud to 35 feet and 10 sacks cement at 35 feet to 0.

RECEIVED
STATE CORPORATION COMMISSION

APR 17 1967

CONSERVATION DIVISION
Wichita, Kansas

Name of Plugging Contractor Sargent's Casing Pulling Service 4-17-67
Address Box 506 Liberal, Kansas

STATE OF Kansas, COUNTY OF Seward, ss.
T. W. Mahoney (employee of owner) or (owner or operator) of the above-described well, being first duly sworn on oath, says: That I have knowledge of the facts, statements, and matters herein contained and the log of the above-described well as filed and that the same are true and correct. So help me God.

(Signature) T. W. Mahoney
Box 1257, Liberal, Kansas 67801 (Address)

SUBSCRIBED AND SWORN to before me this 15 day of April, 19 67

My commission expires January 24, 1968 George W. Carnahan, Jr. Notary Public.

WELL RECORD

Company Citizen Service Oil Company Well No. 3 Farm Hagenan
 Location 330' South and 330' West of NE Corner Sec. 15 T. 29 R. 9W
 Elevation 1702 (1700 Gr.) County Kingman State Kansas
 Drlg. Comm. October 27, 1954 Contractor Prime Drilling Company
 Drlg. Comp. November 12, 1954 Acid None
 F. D. 4513' Initial Prod. Physical Potential: 115 oil, no water, 24 hrs. (11-30-54)
 F. B. T. D. 4499'

CASING RECORD:

8-5/8" @ 313' cem. 225 sz cement
 5-1/2" @ 4513' cem. 150 sz cement

FORMATION RECORD:

sand	0-85
red bed	313
red bed & shale	600
shale & shells	1360
anhydrite	1390
shale & lime	1500
lime & shale	2115
shale & lime	2875
lime & shale	3100
lime	3975
shale & lime	4000
lime & shale	4175
shale & lime	4195
chert & lime	4268
lime	4310
lime & shale	4480
lime	4494
lime & chert	4513

4513 RTD = 4513 SLM

Lansing	3554'
Mississippi	4196'
Binderhook	4304'
Viola	4483'
Penetration	30'
Total Depth	4513'

Drilled cement to 4499 S. L. M.

Perf. 32 shots 4463-91; 1150' oil in 1 1/2 hrs.

SLOPE TESTS (SURE SHOT):

500'	3/16"
1000'	1/20"
1500'	1/40"
2000'	3/4"
2500'	1"
3000'	1"
3500'	1"
4000'	3/4"

RECEIVED
STATE CORPORATION COMMISSION

MAR 31 1967

CONSERVATION DIVISION
Wichita, Kansas