


STATE OF KANSAS
STATE CORPORATION COMMISSION

Form CP-4

Give All Information Completely
Make Required Affidavit
Mail or Deliver Report to:
Conservation Division
State Corporation Commission
212 No. Market
Wichita, Kansas

WELL PLUGGING RECORD

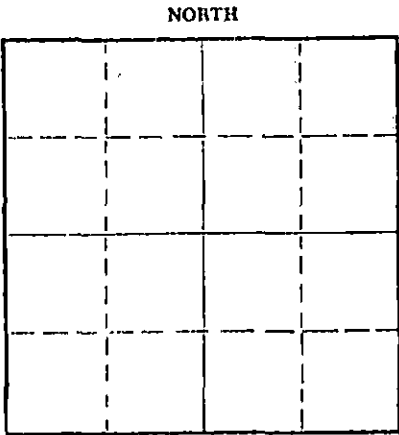

Locate well correctly on above
Section Plat

Kingman County, Sec. 14 Twp. 29 Rge. 9 (E) (W) X
Location as "NE/CNWxSWx" or footage from lines 330' S & 990' E of NW
Lease Owner Drillers Producers Pipe & Supply, Inc.
Lease Name Mueller Well No. C-1
Office Address P. O. Box 368 Great Bend, Kansas
Character of Well (completed as Oil, Gas or Dry Hole) _____
Date well completed _____ 19____
Application for plugging filed 4-3-67 19____
Application for plugging approved 4-1-67 19____
Plugging commenced 4-20-67 19____
Plugging completed 4-23-67 19____
Reason for abandonment of well or producing formation _____

If a producing well is abandoned, date of last production _____ 19____
Was permission obtained from the Conservation Division or its agents before plugging was commenced? Yes

Name of Conservation Agent who supervised plugging of this well Archie V. Elving
Producing formation _____ Depth to top _____ Bottom _____ Total Depth of Well PR 1616 Feet
Show depth and thickness of all water, oil and gas formations.

OIL, GAS OR WATER RECORDS

CASING RECORD

FORMATION	CONTENT	FROM	TO	SIZE	PUT IN	PULLED OUT
				8 5/8	3/7	None
				5 1/2	None	3/51

Describe in detail the manner in which the well was plugged, indicating where the mud fluid was placed and the method or methods used in introducing it into the hole. If cement or other plugs were used, state the character of same and depth placed, from _____ feet to _____ feet for each plug set.

Moved in. Cleaned out cellar.

Sanded to 1450'. Dumped 5 sacks of cement. Working pipe, Loaded hole.
Shot pipe at 3700' and 3600'.

Working pipe. Shot pipe at 3500' and 3430'. Pulling pipe.

Pulling pipe. Plugging well. Build rock bridge at 310'. Dumped 25 sacks
of cement. Filled hole and rock bridge. Capped well with 10 sacks of
cement.

RECEIVED
STATE CORPORATION COMMISSION
MAY 2 1967
CONSERVATION DIVISION
Wichita, Kansas
5-267

(If additional description is necessary, use BACK of this sheet)
Name of Plugging Contractor Forbes Casing Pulling, Inc.
Address P. O. Box 221 Great Bend, Kansas

STATE OF Kansas, COUNTY OF Barton, ss.
J. O. Forbes (employee of owner) or (owner or operator) of the above-described well, being first duly sworn on oath, says: That I have knowledge of the facts, statements, and matters herein contained and the log of the above-described well as filed and that the same are true and correct. So help me God.

(Signature) [Signature]
P. O. Box 221 Great Bend, Kansas
(Address)

SUBSCRIBED AND SWORN TO before me this 28 day of April, 19 67

My commission expires May 27, 1969
[Signature] Notary Public.

WELL RECORD

Company..... Cities Service Oil Co. Well No. 1 Farm Mueller "G"
 Location..... 330' South and 990' East of NE' Cor. Sec. 14 T. 29 R. 9W
 Elevation..... 1694 (1692 Gr.) County Kingman State Kansas
 Drlg. Comm. June 18, 1954 Contractor Prime Drilling Company
 Drlg. Comp. July 9, 1954 Acid 1000 gals. 7-15-54
 T. D. 4657' Initial Prod. Draw-down: 3000 oil, no water, 24 hrs. (6-10-54)
 P. B. T. D. 4646' Ind. Cap. 3295 bbis. per day.

CASING RECORD:

3-5/8" @ 347' con. 225 oz cement
 5-1/2" @ 4656' con. 150 oz cement

FORMATION RECORD:

surface soil & sand	0-40
sand	45
red bed & shale	315
shale & shells	347
red bed & shale	770
red be, shale & shells	840
shale & shells	1200
shale & lime	1390
lime & shale	1860
lime	1970
lime & shale	1990
shale & lime	2970
lime & shale	2980
lime	3490
lime & shale	3637
lime	4025
lime & shale	4185
lime	4205
cherty lime	4275
lime, chert & shale	4405
lime & shale	4475
chert	4485
cherty lime	4525
sand & shale	4610
shale & sand	4640
cherty lime	4660

4660 RTD = 4657 SLH

Corr. Reebner	3335'
Corr. Dodge	3352'
Corr. Douglas	3367'
Corr. Lansing	3547'
Corr. Mississippi	4191'
Corr. Kinderhook	4299'
Corr. Miscner	4462'
Corr. Viola	4472'
Corr. Simpson (Sand)	4517'
Corr. Arbuckle	4630'
Penetration	27'
Total Depth	4657'

P. B. T. D. 4646 S. L. H.

Perf. 69 shots 4473-90; 643' oil
 in 1 hr. 50 mins.

• SLOPE TESTS (EASTMAN):	350'	1°
	500'	1/2°
	1000'	0°
	1500'	3/4°
	2000'	0°
	2500'	0°
	3000'	1/2°
	3500'	0°

RECEIVED
 STATE CONSERVATION COMMISSION
 APR 4 1967
 CONSERVATION DIVISION
 Wichita, Kansas