

STATE OF KANSAS
STATE CORPORATION COMMISSION

WELL PLUGGING RECORD

Give All Information Completely
Make Required Affidavit
Mail or Deliver Report to:
Conservation Division
State Corporation Commission
800 Biting Building
Wichita, Kansas

Kiowa

County, Sec. 23 Twp. 29-S Rge. (E) 17 (W)

Location as "NE/CNW&SW" or footage from lines 2500' F/East Line, 2310' f/No. line

Lease Owner Barbara Oil Company

Lease Name Richard Robbins Well No. 1

Office Address 322 Central Building, Wichita 2, Kansas

Character of Well (completed as Oil, Gas or Dry Hole) Dry Hole

Date well completed July 26, 19 56


Application for plugging filed July 26, 19 56

Application for plugging approved Verbaly July 26, 19 56

Plugging commenced July 26, 19 56

Plugging completed July 26, 19 56

Reason for abandonment of well or producing formation Dry

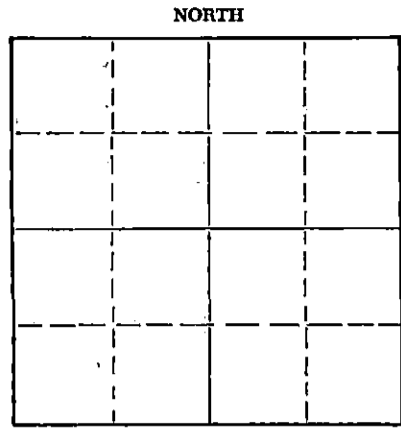

Locate well correctly on above Section Plat

If a producing well is abandoned, date of last production 19

Was permission obtained from the Conservation Division or its agents before plugging was commenced? Yes

Name of Conservation Agent who supervised plugging of this well M.A. Rives

Producing formation Depth to top Bottom Total Depth of Well 4767 Feet

Show depth and thickness of all water, oil and gas formations.

OIL, GAS OR WATER RECORDS

CASING RECORD

FORMATION	CONTENT	FROM	TO	SIZE	PUT IN	PULLED OUT
				8-5/8"	320'	None

Describe in detail the manner in which the well was plugged, indicating where the mud fluid was placed and the method or methods used in introducing it into the hole. If cement or other plugs were used, state the character of same and depth placed, from feet to feet for each plug set.

Filled from total depth to 310' with heavy mud, set plug, used 35 sacks cement, filled up to within 20' of top, set another plug and used 15 sacks cement, filling to surface.

(If additional description is necessary, use BACK of this sheet)

Name of Plugging Contractor Pickrell Drilling Company
Address 705 Fourth National Bank Building, Wichita 2, Kansas

STATE OF Kansas, COUNTY OF Sedgwick, ss. L.W. Davidson (employee) (employee of owner) or (owner or operator) of the above-described

well, being first duly sworn on oath, says: That I have knowledge of the facts, statements, and matters herein contained and the log of the above-described well as filed and that the same are true and correct. So help me God.

(Signature) L.W. Davidson
322 Central Building, Wichita 2, Kansas (Address)

SUBSCRIBED AND SWORN to before me this 26th day of July, 19 56

My commission expires March 2, 1957

Notary Public. RECEIVED STATE CORPORATION COMMISSION

PLUGGING
FILE SEC 23 T 29 R 17W
BOOK PAGE 84 LINE 19

JUL 27 1956 7-27-1956
CONSERVATION DIVISION
Wichita, Kansas

ROTARY DRILLING LOG

COMPANY: Barbara Oil Company
322 Central Building, Wichita, Kansas

Rotary Drilling Commenced 7/7/56

LOCATION: Robbins #1 - ~~6-8/2-SW~~ NW Sec. 23-29-17W
Klowa County, Kansas

Rotary Drilling Completed 7/26/56

CONTRACTOR: PICKRELL DRILLING COMPANY
Wichita, Kansas

CASING RECORD:

10 Jts of 8 5/8" 2 1/2# Smls. Casing set at 320' with
220 Sax. Cement Circulated.

Filled with heavy mud to 310'; bridged hole and cemented
with 35 sacks cement. Then heavy mud to 35' below cellar
bridged hole and filled with cement to bottom of cellar.

LOG

(Figures indicate bottom of formation - measurements from top of rotary bushing.)

Sand Clay	110	Circ. for samples at	3275'
Red Bed	235		3419
Anhydrite	320		3571
Red Bed	860		3675
Anhydrite	888		3841
Shale & shells	1630		3874
Shale & lime	2005		3887
Lime	2210		3943
Lime & shale	2315		4065
Lime	2400		4120
Lime and sand	2510		4130
Lime	2835		4163
Lime & shale	3300		4230
Lime	3346		4288
Lime & shale	3427		4297
Lime	3517		4632
Lime & shale	3635		4650
Lime	3840		4693
Lime & shale	3887		4764
Lime	3963		
Lime & shale	4093		
Lime	4524		
Lime & shale	4574		
Lime	4611		
Mississippi	4764	RTD	

Slope Test at 500', 1000', 1500', 2000',
2500', 3000', 3500', 4000', 4500'
S.L.M. at 1,000, 2,000, 3,000, 4,000

PLUGGING
FILE SEC. 23 T. 29 R. 17W
BOOK PAGE 34 LINE 19

RECORDED
STATE CORPORATION COMMISSION
AUG 8 1956
CONSERVATION DIVISION
Wichita, Kansas

The undersigned, C. W. Sebitts, Attorney-in-Fact for PICKRELL DRILLING COMPANY, hereby certifies in behalf of said Company, that the above is a true and correct log of the formation encountered in drilling the above well as reflected by the Daily Drilling Reports.

PICKRELL DRILLING COMPANY
By C. W. Sebitts
Attorney-in-Fact

STATE OF KANSAS,
COUNTY OF SEDGWICK } ss.

On this 7th day of August, 19 56, before me the undersigned, a Notary Public, in and for

the County and State aforesaid, personally appeared C. W. Sebitts, to me known to be the identical person who subscribed the name of PICKRELL DRILLING COMPANY to the foregoing instrument as its Attorney-in-Fact and acknowledged to me that he executed the same as his free and voluntary act and deed, and as the free and voluntary act and deed of such company, for the uses and purposes therein set forth.

Given under my hand and seal of office the day and year last above written.

My commission expires: July 30, 1958

Sarah J. Stites
Notary Public