


STATE OF KANSAS
STATE CORPORATION COMMISSION

Form CP-4

Give All Information Completely
Make Required Affidavit
Mail or Deliver Report to:
Conservation Division
State Corporation Commission
212 No. Market
Wichita, Kansas

WELL PLUGGING RECORD

NORTH

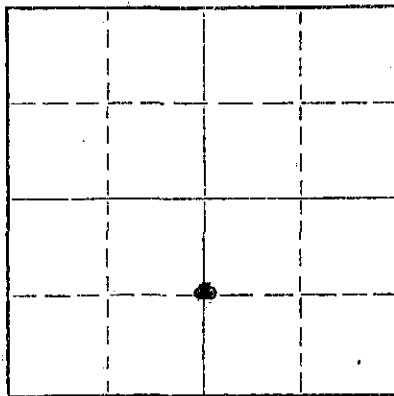

Locate well correctly on above
Section Plat

Location as "NE/CNW&SWK" or footage from lines W/2 SW NE
County. Sec. 23 Twp. 29 Rge. 17 (E) (W)
Lease Owner Petrodynamics, Inc.
Lease Name Robbins A Well No. 1-23
Office Address P. O. Box 10006 Amarillo, Texas
Character of Well (completed as Oil, Gas or Dry Hole) Gas
Date well completed 11-27 1963
Application for plugging filed 8-5 1970
Application for plugging approved 8-5 1970
Plugging commenced 8-8 1970
Plugging completed 8-11 1970
Reason for abandonment of well or producing formation Well to small to produce
If a producing well is abandoned, date of last production Never Produced 19
Was permission obtained from the Conservation Division or its agents before plugging was commenced? Yes

Name of Conservation Agent who supervised plugging of this well G. R. Biberstein
Producing formation Mississippi Depth to top 4620 Bottom 4645 Total Depth of Well 4750 Feet
Show depth and thickness of all water, oil and gas formations.

OIL, GAS OR WATER RECORDS

CASING RECORD

FORMATION	CONTENT	FROM	TO	SIZE	PUT IN	PULLED OUT
Mississippi	Gas	4624	4641	4 1/2	4750	2458
				8 5/8	320	-0-

Describe in detail the manner in which the well was plugged, indicating where the mud fluid was placed and the method or methods used in introducing it into the hole. If cement or other plugs were used, state the character of same and depth placed, from _____ feet to _____ feet for each plug set.

Mixed and pumped 25 sacks cement with plug from 4018' to 3718', Pulled 30 joints of pipe, well unloaded, and blown for 5 hours before could stab swedge with valve, Halliburton pumped 500 sacks cement down 4 1/2" casing, Spotted 50 sacks cement from 390' to 240', Ran 10 sacks cement from 4' to 34'.

RECEIVED
STATE CORPORATION COMMISSION
AUG 17 1970
CONSERVATION DIVISION
Wichita, Kansas

(If additional description is necessary, use BACK of this sheet)

Name of Plugging Contractor Daco Lease & Well Service
Address 1700 South Main Borger, Texas 79007

STATE OF Texas COUNTY OF Hutchinson, ss.
J. L. Martin Jr. (employee of owner) or ~~(owner or operator)~~ of the above-described well, being first duly sworn on oath, says: That I have knowledge of the facts, statements, and matters herein contained and the log of the above-described well as filed and that the same are true and correct. So help me God.

(Signature) J. L. Martin Jr.
827 Latimer Borger, Texas
(Address)

SUBSCRIBED AND SWORN to before me this 14 day of August, 19 70

My commission expires June 1, 1971 Sharon Shelton Notary Public.