

15-097-00227-0000

STATE OF KANSAS  
STATE CORPORATION COMMISSION


Form CP-4

Give All Information Completely  
Make Required Affidavit  
Mail or Deliver Report to:  
Conservation Division  
State Corporation Commission  
211 No. Broadway  
Wichita, Kansas

WELL PLUGGING RECORD

Kiowa County, Sec. 27 Twp. 29S Rge. (E) 17 (W)  
Location as "NE/CNW/SW" or footage from lines C SW NE  
Lease Owner Jas. F. Smith  
Lease Name Robbins Well No. 1-27  
Office Address P. O. Box 10005, Amarillo, Texas 79106  
Character of Well (completed as Oil, Gas or Dry Hole) Dry hole  
Date well completed May 16, 19 64  
Application for plugging filed (Orally) May 16, 19 64  
Application for plugging approved (Orally) May 16, 19 64  
Plugging commenced May 17, 19 64  
Plugging completed May 17, 19 64  
Reason for abandonment of well or producing formation \_\_\_\_\_

NORTH

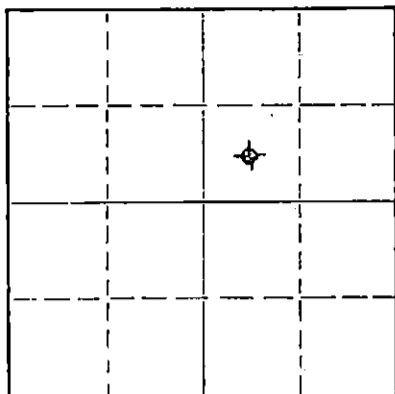

Locate well correctly on above  
Section Plat

If a producing well is abandoned, date of last production \_\_\_\_\_ 19\_\_\_\_  
Was permission obtained from the Conservation Division or its agents before plugging was commenced? Yes

Name of Conservation Agent who supervised plugging of this well Archie Elving  
Producing formation None Depth to top \_\_\_\_\_ Bottom \_\_\_\_\_ Total Depth of Well 4804 Feet  
Show depth and thickness of all water, oil and gas formations.

OIL, GAS OR WATER RECORDS

CASING RECORD

FORMATION	CONTENT	FROM	TO	SIZE	PUT IN	PULLED OUT
Mississippi Chat	Dry	4734	T.D.	8-5/8	376	None

Describe in detail the manner in which the well was plugged, indicating where the mud fluid was placed and the method or methods used in introducing it into the hole. If cement or other plugs were used, state the character of same and depth placed, from \_\_\_\_\_ feet to \_\_\_\_\_ feet for each plug set.

Filled with heavy mud to 275'. First plug at 275' with 1/4 sack hulls and 25 sacks cement. Filled with heavy mud to 40'. Second plug at 40' with 1/4 sack hulls and 10 sacks cement.

RECEIVED  
STATE CORPORATION COMMISSION

MAY 21 1964

CONSERVATION DIVISION  
Wichita, Kansas

(If additional description is necessary, use BACK of this sheet)

Name of Plugging Contractor Bowers Drilling Company  
Address Union Center Building, Wichita, Kansas

STATE OF TEXAS, COUNTY OF POTTER, ss.  
George Dobervich (employee of owner ~~xxxxxx operator~~) of the above-described well, being first duly sworn on oath, says: That I have knowledge of the facts, statements, and matters herein contained and the log of the above-described well as filed and that the same are true and correct. So help me God.

(Signature) George Dobervich  
P. O. Box 10005, Amarillo, Texas 79106  
(Address)

SUBSCRIBED AND SWORN TO before me this 20th day of May, 19 64

Faye Fluty  
Faye Fluty  
Notary Public.

My commission expires June 1, 1965