


STATE OF KANSAS  
STATE CORPORATION COMMISSION

WELL PLUGGING RECORD

Give All Information Completely  
Make Required Affidavit  
Mail or Deliver Report to  
Conservation Division  
State Corporation Comm.  
245 North Water  
Wichita, KS 67202

Kiowa County, Sec. 2 Twp. 29S Rge. 19W E/W  
Location as "NE/CNW $\frac{1}{4}$ SW $\frac{1}{4}$ " or footage from lines  
C NE SW

Lease Owner D. R. Lauck Oil Company, Inc.  
Lease Name Unruh "A" Well No. 1  
Office Address 221 S. Broadway, Suite 400, Wichita, KS 67202  
Character of Well (Completed as Oil, Gas or Dry Hole)  
Dry Hole

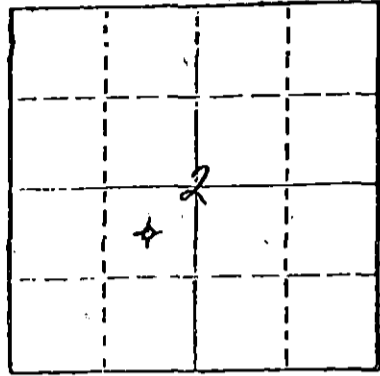

Locate well correctly on above  
Section Plot

Date Well completed October 6, 1980  
Application for plugging filed October 6, 1980  
Application for plugging approved October 6, 1980  
Plugging commenced October 6, 1980  
Plugging completed October 6, 1980  
Reason for abandonment of well or producing formation  
Dry Hole

If a producing well is abandoned, date of last production  
19

Was permission obtained from the Conservation Division or  
its agents before plugging was commenced? Yes

Name of Conservation Agent who supervised plugging of this well Wm. T. Owen  
Producing formation Depth to top Bottom Total Depth of Well 5000'  
Show depth and thickness of all water, oil and gas formations.

OIL, GAS OR WATER RECORDS

CASING RECORD

FORMATION	CONTENT	FROM	TO	SIZE	PUT IN	PULLED OUT
		0'	346'	8-5/8"	341.67'	None

Describe in detail the manner in which the well was plugged, indicating where the mud fluid  
was placed and the method or methods used in introducing it into the hold. If cement or other  
plugs were used, state the character of same and depth placed, from feet to  
feet for each plug set.

Plugged with 40 sacks cement at 600';  
40 sacks cement at 330'; 10 sacks cement  
at 40'; and 10 sacks cement in rat hole.

RECEIVED  
STATE CORPORATION COMMISSION  
OCT 24 1980  
CONSERVATION DIVISION  
Wichita, Kansas

(If additional description is necessary, use BACK of this well report)  
Name of Plugging Contractor Allied Cementing Co.

STATE OF KANSAS COUNTY OF SEDGWICK, ss.  
John D. Knightley (employee of owner) or (owner or operator)

of the above-described well, being first duly sworn on oath, says: That I have knowledge of  
the facts, statements, and matters herein contained and the log of the above-described well  
as filed and that the same are true and correct. So help me God.

(Signature) [Signature]  
221 S. Broadway, Suite 400, Wichita, KS 67202  
(Address)

SUBSCRIBED AND SWORN TO before me this 23rd day of October, 1980

NOTARY  
STELLA J. LIPPA  
PUB. [unclear]  
VICK

[Signature]  
Notary Public.

My commission expires March 12, 1983

D. R. Lauck Oil Company, Inc. - Unruh "A" #1  
 221 S. Broadway, Suite 400 C NE SW Sec. 2-29S-19W  
 Wichita, Kansas 67202 Kiowa County, Kansas

Contractor: D. R. Lauck Oil Company, Inc.  
 221 S. Broadway, Suite 400  
 Wichita, Kansas 67202

Commenced: September 24, 1980  
 Completed: October 6, 1980

Drillers Log

Clay, Sand & Shale	160
Gyp & Shale	350
Clay & Sand	540
Red Bed & Shale	685
Shale & Shells	1370
Shale	2170
Shale & Lime	2490
Shale	2735
Shale & Lime	2935
Lime & Shale	3335
Shale & Lime	3500
Lime & Shale	4100
Lime	4368
Lime & Shale	4500
Lime	4865
Lime & Shale	4917
Shale & Lime	4939
Lime	5000 RTD

RECEIVED  
 STATE CORPORATION COMMISSION

OCT 24 1980

CONSERVATION DIVISION  
 Wichita, Kansas