


STATE OF KANSAS
STATE CORPORATION COMMISSION

WELL PLUGGING RECORD

Give All Information Completely
Make Required Affidavit
Mail or Deliver Report to
Conservation Division
State Corporation Comm.
245 North Water
Wichita, KS 67202

Kiowa County: Sec. 2 Twp. 29 Rge. 19 E/W
Location as "NE/CNW $\frac{1}{4}$ SW $\frac{1}{4}$ " or footage from lines
C SE NW

Lease Owner Pickrell Drilling Company
Lease Name Schmidt "Q" Well No. 1
Office Address 205 Litwin Bldg., Wichita, Kansas
Character of Well (Completed as Oil, Gas or Dry Hole) 67202

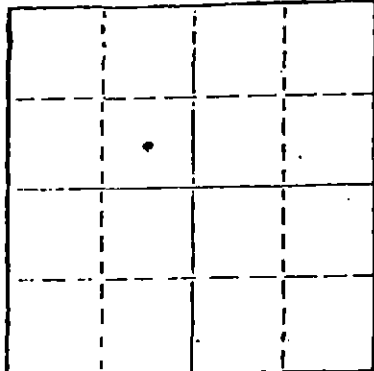

Locate well correctly on above
Section Plat

gas
Date Well completed Sept. 30 19 75
Application for plugging filed July 21 19 77
Application for plugging approved 19
Plugging commenced July 22 19 77
Plugging completed Oct. 18 19 77
Reason for abandonment of well or producing formation depleted

If a producing well is abandoned, date of last production 19

Was permission obtained from the Conservation Division or its agents before plugging was commenced? yes

Name of Conservation Agent who supervised plugging of this well Jasper Metz
Producing formation Depth to top Bottom Total Depth of Well 5015'
Show depth and thickness of all water, oil and gas formations.

OIL, GAS OR WATER RECORDS

CASING RECORD

FORMATION	CONTENT	FROM	TO	SIZE	PUT IN	PULLED OUT
		0	254'	8 5/8"	254'	none
			5013'	4 1/2"	5013'	2527.72

Describe in detail the manner in which the well was plugged, indicating where the mud fluid was placed and the method or methods used in introducing it into the hold. If cement or other plugs were used, state the character of same and depth placed, from feet to feet for each plug set.

Sanded back to 4875' and dumped 4 sacks of cement.

Allied Cementing Company plugged well pumping in 3 sacks of hulls, 20 sacks of gel and 100 sacks of cement.

RECEIVED
STATE CORPORATION COMMISSION

OCT 22 1977

10-22-1977

CONSERVATION DIVISION

(If additional description is necessary, use BACK of this sheet)

Name of Plugging Contractor PIPE PULLERS, INC.
Box 128, Ellinwood, Kansas 67526

STATE OF KANSAS COUNTY OF BARTON, ss.
Evelyn Roth (employee of owner) or (~~owner or operator~~)
of the above-described well, being first duly sworn on oath, says: That I have knowledge of the facts, statements, and matters herein contained and the log of the above-described well as filed and that the same are true and correct. So help me God.

(Signature) Evelyn Roth
Ellinwood, Kansas
(Address)

SUBSCRIBED AND SWORN TO before me this 24th day of October, 19 77

JENNY KASSELMAN
NOTARY PUBLIC
BARTON COUNTY, KANSAS
MY COMM. EXP. JULY 16, 1978

My commission expires

Jenny Kasselmann
Notary Public.

COMPANY: PICKRELL DRILLING COMPANY
 205 LITWIN BLDG.,
 WICHITA, KS. 67202
 LOCATION: Schmidt "Q" #1
 SE NW 2-29S-19W
 Kiowa County, Kansas
 CONTRACTOR: PICKRELL DRILLING COMPANY
 Wichita, Kansas

Rotary Drilling Commenced 9-14-75
 Rotary Drilling Completed 9-30-75

CASING RECORD: 8 5/8 @ 254' with 175 sx. 4 1/2" @ 5013 with 150 sx.

LOG

(Figures indicate bottom of formation — measurements from top of rotary bushing.)

Sand & Clay	190	Lime	4970
Shale	254	Lime	5015
Shale	563		
Shale	740		
Shale & Redbed	1390		
Shale & Redbed	2100		
Shale w/Lime stks.	2150		
Shale & Lime Rough	2400		
Lime	2510		
Lime & Shale	2710		
Lime & Shale	2855		
Shale & Lime	2930		
Lime & Shale	3065		
Lime & Shale	3215		
Lime & Shale	3350		
Lime & Shale	3525		
Lime & Shale	3650		
Lime & Shale	3775		
Lime & Shale	3915		
Lime & Shale	4040		
Lime & Shale	4076		
Lime & Shale	4143		
Lime & Shale	4220		
Lime & Shale	4319		
Lime & Shale	4383		
Lime	4407		
Lime	4457		
Lime	4502		
Lime	4502		
Lime	4566		
Lime	4636		
Lime	4695		
Lime	4770		
Lime & Shale	4840		
Lime & Shale	4907		
Lime & Shale	4911		
Lime & Shale	4955		

RECEIVED
 STATE CORPORATION COMMISSION
 JUL 22 1977
 CONSERVATION DIVISION
 Wichita, Kansas

C. W. Sebitts

The undersigned, _____, Attorney-in-Fact for PICKRELL DRILLING COMPANY, hereby certifies in behalf of said Company, that the above is a true and correct log of the formation encountered in drilling the above well as reflected by the Daily Drilling Reports.

PICKRELL DRILLING COMPANY
 By [Signature]
 Attorney-in-Fact
 C. W. Sebitts

STATE OF KANSAS }
 COUNTY OF SEDGWICK } ss.:

On this 28 day of September, 1976, before me the undersigned, a Notary Public, in and for

the County and State aforesaid, personally appeared C. W. Sebitts, to me known to be the identical person who subscribed the name of PICKRELL DRILLING COMPANY to the foregoing instrument as its Attorney-in-Fact and acknowledged to me that he executed the same as his free and voluntary act and deed, and as the free and voluntary act and deed of such company, for the uses and purposes therein set forth.

Given under my hand and seal of office the day and year last above written.



My commission expires: _____
[Signature]
 Jo Ann Sarver Notary Public



BAKER OIL TOOLS, INC.

SERVING THE WORLD

DATE 7-21-77 WELL NO. Q-1 LEASE Schmidt FIELD Joy Station SE

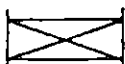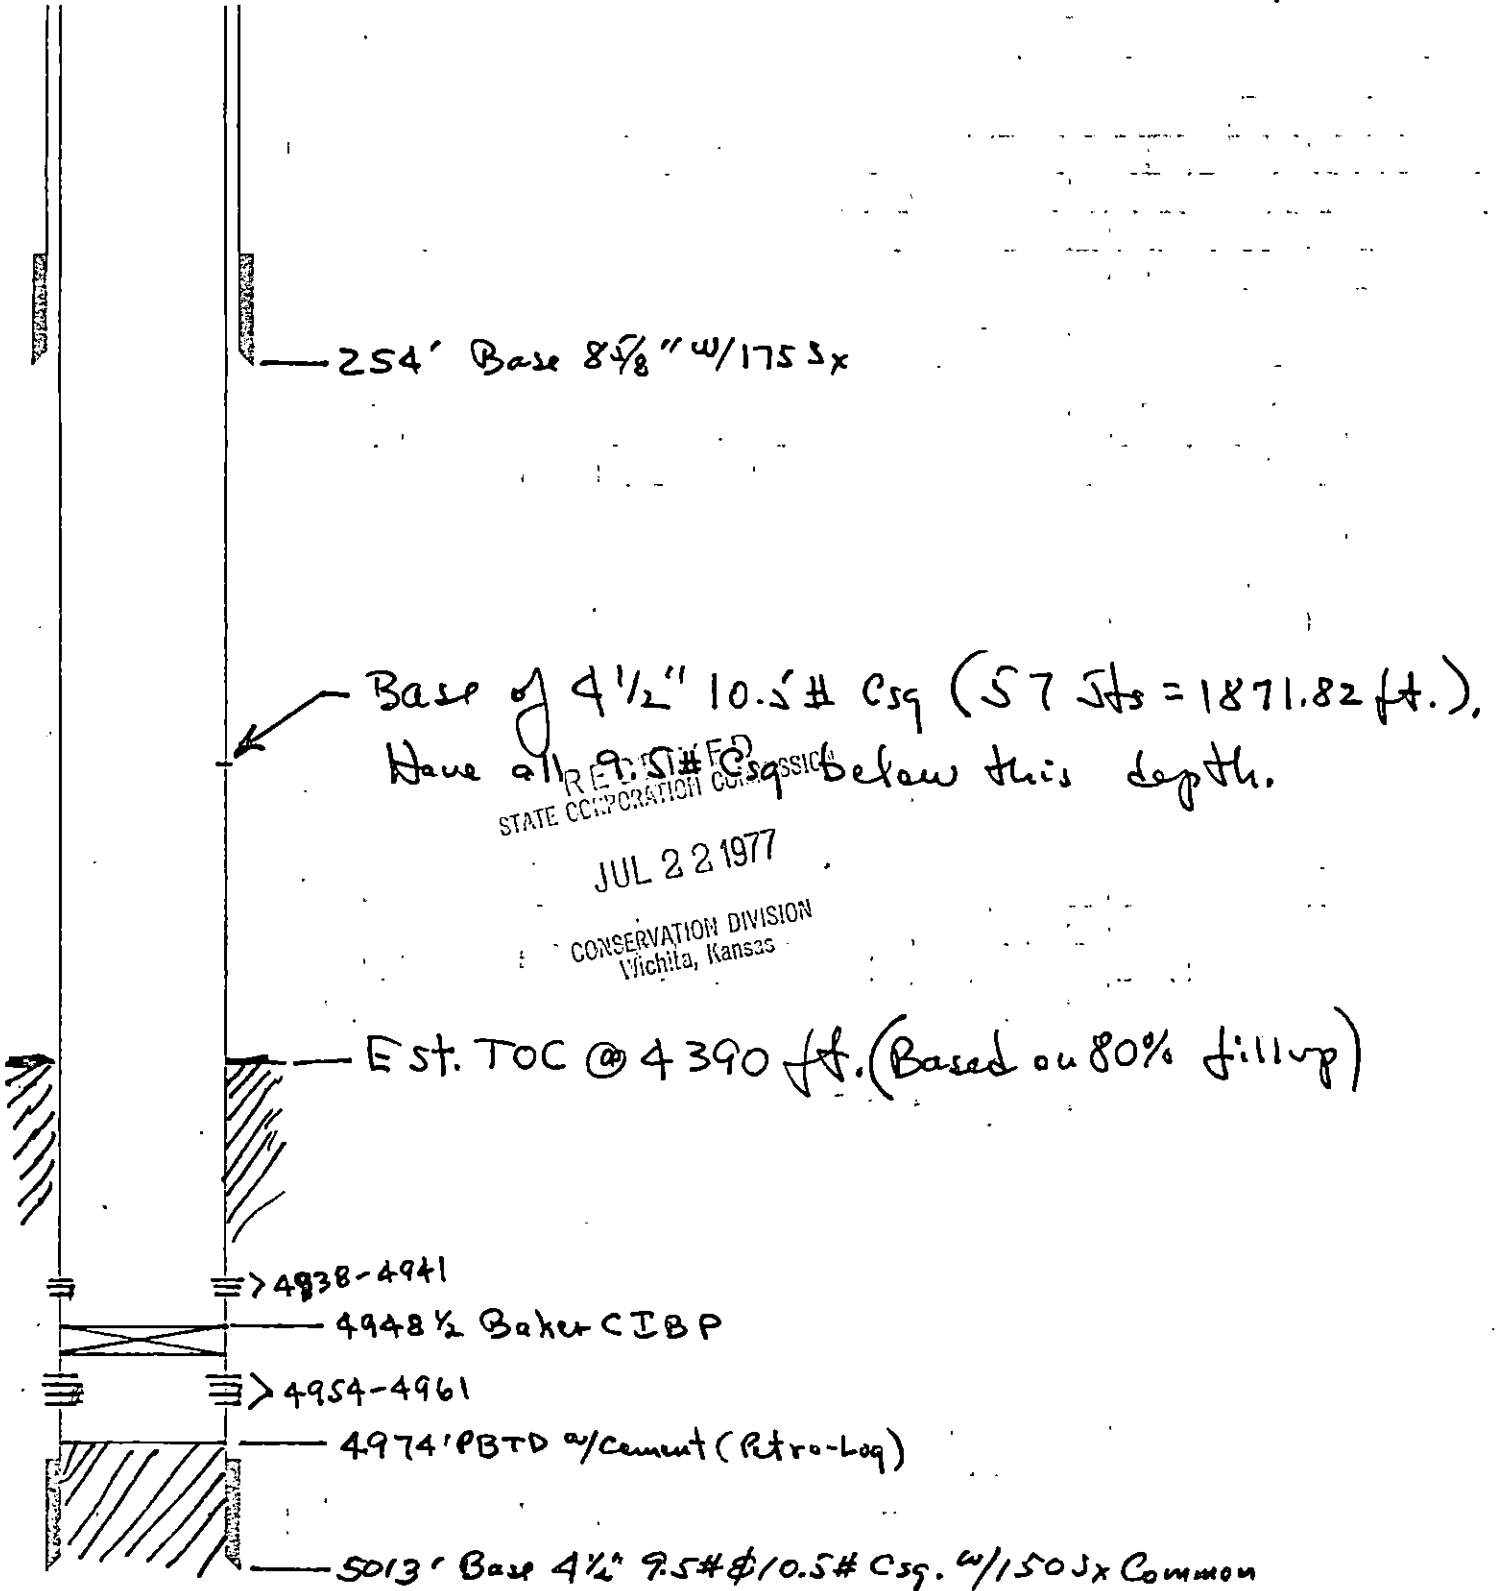

BRIDGE PLUG



PACKER



CENTRALIZER



SCRATCHER



BASKET



PERFORATIC