


STATE OF KANSAS  
STATE CORPORATION COMMISSION

Form CP-4

Give All Information Completely  
Make Required Affidavit  
Mail or Deliver Report to:  
Conservation Division  
State Corporation Commission

P. O. Box 17027  
Wichita, Kansas 67217  
NORTH

WELL PLUGGING RECORD

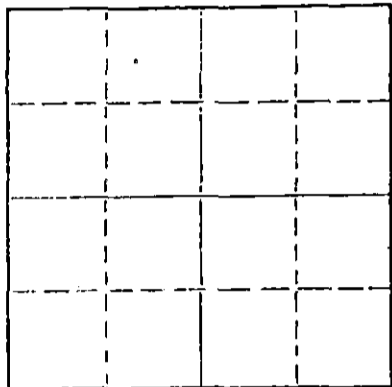

Locate well correctly on above  
Section Plat

Kiowa County. Sec. 15 Twp. 29S Rge. 19W (E) (W)  
Location as "NE/CNW%SW%" or footage from lines C NW SW  
Lease Owner National Oil Company  
Lease Name McLain Well No. 1  
Office Address Suite 550, 200 W. Douglas, Wichita, Ks.  
Character of Well (completed as Oil, Gas or Dry Hole) D & A  
Date well completed December 22 1973  
Application for plugging filed December 22 1973  
Application for plugging approved December 22 1973  
Plugging commenced December 22 1973  
Plugging completed December 22 1973  
Reason for abandonment of well or producing formation D & A

If a producing well is abandoned, date of last production 19  
Was permission obtained from the Conservation Division or its agents before plugging was commenced? Yes

Name of Conservation Agent who supervised plugging of this well Bieberstien  
Producing formation \_\_\_\_\_ Depth to top \_\_\_\_\_ Bottom \_\_\_\_\_ Total Depth of Well 5130 Feet  
Show depth and thickness of all water, oil and gas formations.

OIL, GAS OR WATER RECORDS

CASING RECORD

| FORMATION | CONTENT | FROM | TO | SIZE  | PUT IN | PULLED OUT |
|-----------|---------|------|----|-------|--------|------------|
|           |         |      |    | 8 5/8 | 673'   | -0-        |
|           |         |      |    |       |        |            |
|           |         |      |    |       |        |            |
Describe in detail the manner in which the well was plugged, indicating where the mud fluid was placed and the method or methods used in introducing it into the hole. If cement or other plugs were used, state the character of same and depth placed, from \_\_\_\_\_ feet to \_\_\_\_\_ feet for each plug set.

Plug @ 500' w/40 sx. Plug @ 300'  
w/305 sx. Plug @ 40' w/10 sx.

RECEIVED  
STATE CORPORATION COMMISSION  
DEC 28 1973  
CONSERVATION DIVISION  
Wichita, Kansas

(If additional description is necessary, use BACK of this sheet)  
Name of Plugging Contractor B & B Drilling, Inc.  
Address 720 Union Center, Wichita, Ks.

STATE OF Kansas, COUNTY OF Sedgwick, ss.  
Bill Lahar (employee of owner) or (owner or operator) of the above-described well, being first duly sworn on oath, says: That I have knowledge of the facts, statements, and matters herein contained and the log of the above-described well as filed and that the same are true and correct. So help me God.

(Signature) Bill Lahar  
Bill Lahar  
720 Union Center, Wichita, Ks.  
(Address)


Subscribed and sworn to before me this 26th day of December, 19 73

Betty M. Maloney  
Betty M. Maloney Notary Public.

Give All Information Completely  
Make Required Affidavit  
Mail or Deliver Report to:  
Conservation Division  
State Corporation Commission

WELL PLUGGING RECORD

P. O. Box 17027  
Wichita, Kansas 67217  
NORTH

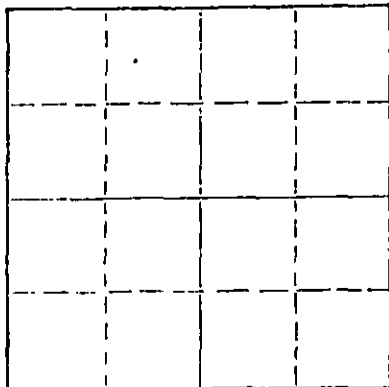

Locate well correctly on above  
Section Plat

Kiowa County. Sec. 15 Twp. 29S Rge. 19W (E) (W)  
Location as "NE/CNW/SW" or footage from lines C NW SW  
Lease Owner National Oil Company  
Lease Name McLain Well No. 1  
Office Address Suite 550, 200 W. Douglas, Wichita, Ks.  
Character of Well (completed as Oil, Gas or Dry Hole) D & A  
Date well completed December 22 19 73  
Application for plugging filed December 22 19 73  
Application for plugging approved December 22 19 73  
Plugging commenced December 22 19 73  
Plugging completed December 22 19 73  
Reason for abandonment of well or producing formation D & A

If a producing well is abandoned, date of last production 19  
Was permission obtained from the Conservation Division or its agents before plugging was commenced? Yes

Name of Conservation Agent who supervised plugging of this well Bieberstien  
Producing formation \_\_\_\_\_ Depth to top \_\_\_\_\_ Bottom \_\_\_\_\_ Total Depth of Well 5130 Feet  
Show depth and thickness of all water, oil and gas formations.

OIL, GAS OR WATER RECORDS

CASING RECORD

| FORMATION | CONTENT | FROM | TO | SIZE  | PUT IN | PULLED OUT |
|-----------|---------|------|----|-------|--------|------------|
|           |         |      |    | 8 5/8 | 673'   | -0-        |
|           |         |      |    |       |        |            |
|           |         |      |    |       |        |            |
Describe in detail the manner in which the well was plugged, indicating where the mud fluid was placed and the method or methods used in introducing it into the hole. If cement or other plugs were used, state the character of same and depth placed, from \_\_\_\_\_ feet to \_\_\_\_\_ feet for each plug set.

Plug @ 500' w/40 sx. Plug @ 300'  
w/305 sx. Plug @ 40' w/10 sx.

RECEIVED  
STATE CORPORATION COMMISSION  
DEC 28 1973  
CONSERVATION DIVISION  
Wichita, Kansas

(If additional description is necessary, use BACK of this sheet)  
Name of Plugging Contractor B & B Drilling, Inc.  
Address 720 Union Center, Wichita, Ks.

STATE OF Kansas, COUNTY OF Sedgwick, ss.

Bill Lahar (employee of owner) or (owner or operator) of the above-described well, being first duly sworn on oath, says: That I have knowledge of the facts, statements, and matters herein contained and the log of the above-described well as filed and that the same are true and correct. So help me God.

(Signature) Bill Lahar  
Bill Lahar  
720 Union Center, Wichita, Ks.  
(Address)

SUBSCRIBED AND SWORN to before me this 26th day of December, 19 73

My commission expires January 29, 1977  
Betty M. Maloney Notary Public.

December 26, 1973

DRILLERS LOG

#1 McLain  
C NW SW  
Sec. 15-29S-19W  
Kiowa County, Kansas

OPERATOR: National Oil Company  
CONTRACTOR: B & B Drilling, Inc.  
COMMENCED: December 8, 1973  
COMPLETED: December 22, 1973

8 5/8" @ 673' w/500 sx

|      |      |              |
|------|------|--------------|
| 0    | 145  | Surface Clay |
| 145  | 225  | Sand         |
| 225  | 1009 | Shale & Sand |
| 1009 | 2175 | Shale        |
| 2175 | 4030 | Lime & Shale |
| 4030 | 4315 | Lime         |
| 4315 | 4400 | Lime & Shale |
| 4400 | 5072 | Lime         |
| 5072 | 5130 | Lime & Chert |
| 5130 |      | RTD          |

RECEIVED  
STATE CORPORATION COMMISSION  
DEC 28 1973  
CONSERVATION DIVISION  
Wichita, Kansas

D & A

We certify that the above and foregoing is a true and correct copy of the log on the #1 McLain, located in Kiowa County, Kansas.

B & B DRILLING, INC.

Bill Lahar  
Bill Lahar

Subscribed and sworn to before me this 26th day of December, 1973.

Betty M. Maloney  
Betty M. Maloney Notary Public

My Commission Expires:

January 29, 1977