


WELL PLUGGING RECORD

Give All Information Completely  
Make Required Affidavit  
Mail or Deliver Report to:  
Conservation Division  
State Corporation Commission  
211 No. Broadway  
Wichita, Kansas

Kiowa County, Sec. 9 Twp. 29S Rge. (E) 19 (W)  
Location as "NE/CNW/SW" or footage from lines C SW/4 SW/4  
Lease Owner Graham-Michaelis Drilling, Inc.  
Lease Name Mac Childress Well No. 1-9  
Office Address 211 North Broadway, Wichita, Kansas 67202  
Character of Well (completed as Oil, Gas or Dry Hole) Dry Hole  
Date well completed November 21, 19 66  
Application for plugging filed January 6, 19 67  
Application for plugging approved January 19, 19 67  
Plugging commenced January 9, 19 67  
Plugging completed January 11, 19 67  
Reason for abandonment of well or producing formation Dry Hole

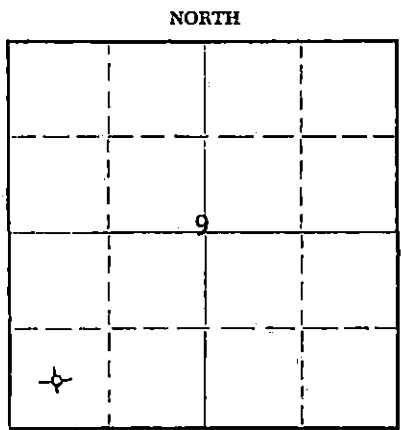

Locate well correctly on above Section Flat

If a producing well is abandoned, date of last production 19  
Was permission obtained from the Conservation Division or its agents before plugging was commenced? Yes

Name of Conservation Agent who supervised plugging of this well A. Elving, Box 248, Pratt, Kansas  
Producing formation none Depth to top Bottom Total Depth of Well 5120' Feet  
Show depth and thickness of all water, oil and gas formations.

OIL, GAS OR WATER RECORDS

CASING RECORD

FORMATION	CONTENT	FROM	TO	SIZE	PUT IN	PULLED OUT
				9 5/8"	749'	none
				4 1/2"	5119'	4556'

Describe in detail the manner in which the well was plugged, indicating where the mud fluid was placed and the method or methods used in introducing it into the hole. If cement or other plugs were used, state the character of same and depth placed, from feet to feet for each plug set.

Mix 15 sacks cement to plug off perforations at 5035'.  
Stop plug at 4850', shoot pipe loose at 4556' and lay down same to 600' and mix 11 sacks of gell. Lay down 6 more joints and pump 35 sacks cement at 400'. Put bridge at 40' and 10 sacks cement at 30 ft. to 0 ft.

RECEIVED  
STATE CORPORATION COMMISSION  
FEB 1 1967  
CONSERVATION DIVISION  
Wichita, Kansas

2-1-1967

(If additional description is necessary, use BACK of this sheet)  
Name of Plugging Contractor Sargent Casing Pulling Service  
Address Box 506, Liberal, Kansas

STATE OF Kansas, COUNTY OF Sedgwick, ss.  
David F. Patterson (employee of owner) or (owner or operator) of the above-described well, being first duly sworn on oath, says: That I have knowledge of the facts, statements, and matters herein contained and the log of the above-described well as filed and that the same are true and correct. So help me God.

(Signature) David F. Patterson  
Box 782, Hooker, Oklahoma (Address)

Subscribed and sworn to before me this 31st day of January, 19 67  
My commission expires Dec. 12, 1970  
Evelyn D. Evans Notary Public.



MAC CHECKRESS NO. 1-2

WELL RECORD:

LOCATION:

0 SW SW Section 9-29S-19W  
Kiowa County, Kansas

Commenced: 11-9-66  
Completed: 11-29-66  
(Notary)

CONTRACTOR:

Graham-Michaels Drilling, Inc.  
Liberal Division  
P. O. Box 1204  
Liberal, Kansas 67901

CASING RECORD:

24 Joints 9-5/8" 32.30' Casing  
Cemented w/350 ax Summit

Surface Sand & Red Bed  
Sand, Red Bed & Gyp  
Red Bed & Shale  
Red Bed, Gyp & Shale  
Lime & Shale  
Lime  
Lime & Shale

100  
0 - 318  
318 - 750  
750 - 1457  
1457 - 1980  
1980 - 5040  
5040 - 5057  
5057 - 5126

5126' - Total Rotary Depth

The undersigned, Graham-Michaels Drilling, Inc., Liberal Division, certifies that the above log is a true and correct copy of the formations encountered in drilling the above mentioned well, as taken from the Daily Drilling Report.

GRAHAM-MICHAELS DRILLING, INC.  
LIBERAL DIVISION

By \_\_\_\_\_  
H. K. Michaels

HRM/rw

