


Give All Information Completely
Make Required Affidavit
Mail or Deliver Report to:
Conservation Division
State Corporation Commission
211 No. Broadway
Wichita, Kansas

WELL PLUGGING RECORD

Kiowa County, Sec. 1 Twp. 29S Rge. (E) 18 (W)

Location as "NE/CNW%SW%" or footage from lines C NW SW
Lease Owner Apache Corporation
Lease Name Wedel Well No. 1
Office Address 823 South Detroit, Tulsa, Oklahoma 74120
Character of Well (completed as Oil, Gas or Dry Hole) Gas (Marginal Well)
Date well completed October 15 19 63
Application for plugging filed September 10 19 64
Application for plugging approved September 11 19 64
Plugging commenced September 22 19 64
Plugging completed September 27 19 64
Reason for abandonment of well or producing formation Excessive salt water and lack of market for gas.
If a producing well is abandoned, date of last production February 1 19 64
Was permission obtained from the Conservation Division or its agents before plugging was commenced? Yes

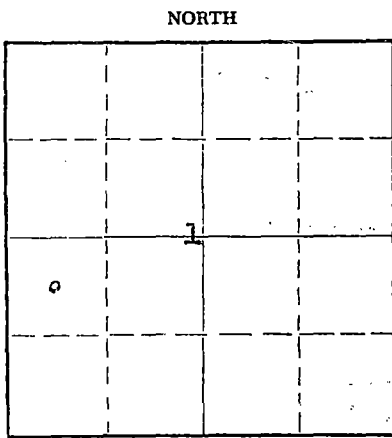

Locate well correctly on above Section Plat

Name of Conservation Agent who supervised plugging of this well Mr. A. Elving
Producing formation Mississippi Depth to top 4874 Bottom 4899 Total Depth of Well 4964 Feet
Show depth and thickness of all water, oil and gas formations.

OIL, GAS OR WATER RECORDS

CASING RECORD

FORMATION	CONTENT	FROM	TO	SIZE	PUT IN	PULLED OUT
Mississippi	Gas & Oil	4874	4936	8-5/8	348'-6"	None
				4-1/2	4962'-8"	4137.78'

Describe in detail the manner in which the well was plugged, indicating where the mud fluid was placed and the method or methods used in introducing it into the hole. If cement or other plugs were used, state the character of same and depth placed, from 4733 feet to 4962 feet for each plug set.

Filled hole with heavy mud laden fluid and set 20 sacks of cement 4962 to 4733 feet. Squeezed 5-1/2 sacks into formation at 800 psi. Cut 4-1/2 inch at 4266 feet, pulled 4-1/2". Refilled hole and set Halliburton wire line plug at 325 feet in 8-5/8 inch OD and spotted 35 sacks of cement in top of surface casing at 40 to 0 feet. Job complete, September 27, 1964.

RECEIVED
STATE CORPORATION COMMISSION

OCT 6 1964

CONSERVATION DIVISION
Wichita, Kansas

10-6-1964

(If additional description is necessary, use BACK of this sheet)
Name of Plugging Contractor Pipe Pullers, Inc., Permit No. 462
Address Ellinwood, Kansas

STATE OF Oklahoma, COUNTY OF Tulsa, ss.
Lloyd D. Somers (employee of owner) or (owner or operator) of the above-described

well, being first duly sworn on oath, says: That I have knowledge of the facts, statements, and matters herein contained and the log of the above-described well as filed and that the same are true and correct. So help me God.

(Signature) Lloyd D. Somers
823 South Detroit, Tulsa, Oklahoma 74120
(Address)

SUBSCRIBED AND SWORN TO before me this 5th day of October, 1964

My commission expires January 7, 1967.

Notary Public.

WELL LOG

COMPANY Apache Oil Corporation

SEC. 1 T. 29S R. 18W

FARM Wedel NO. 1

OC. C. NW SW

TOTAL DEPTH 4961'

COUNTY Kiowa

COMM. 8-24-63

COMP. 9-7-63

CONTRACTOR Garvey Drilling Company

CASING 8 5/8" @ 348' w/300 sx

4 1/2" @ 4962' w/100 sx

RECEIVED
STATE CORPORATION COMMISSION
SEP 11 1964
CONSERVATION DIVISION
MICHIGAN, KANSAS

ELEVATION

PRODUCTION

FIGURES INDICATE BOTTOM OF FORMATIONS

- 200' Surface Clay and Sand
- 350' Blue Shale
- 1169' Shale and Red Bed
- 1200' Anhydrite
- 1925' Red Bed and Shale
- 2510' Shaley Lime
- 2630' Lime and Shale
- 2776' Lime
- 3115' Lime and Shale
- 3256' Limoy Shale
- 3585' Shale and Chalky Lime
- 4046' Shale and Lime
- 4285' Lime and Shale
- 4310' Shale and Lime
- 4436' Lime
- 4475' Cherty Lime
- 4705' Lime
- 4755' Lime and Shale
- 4833' Lime
- 4900' Lime, Shale, and Chert
- 4925' Lime and Chert
- 4941' Mississippi Chert
- 4945' Lime
- 4961' Cherty Lime
- 4961' RTD

State of Kansas }
County of Barton } ss

I, Sam N. k Stephens of Garvey Drilling Company

upon oath state the above and foregoing is a true and correct copy of the log of the Wedel #1 well.

Sam N. Stephens

Subscribed and sworn to before me this 13th day of September 19 63

My Commission Expires: April 14th, 1967

Arthur J. [Signature]
NOTARY PUBLIC