


STATE OF KANSAS
STATE CORPORATION COMMISSION
Give All Information Completely
Make Required Affidavit
Mail or Deliver Report to:
Conservation Division
State Corporation Commission
211 No. Broadway
Wichita, Kansas

WELL PLUGGING RECORD

NORTH

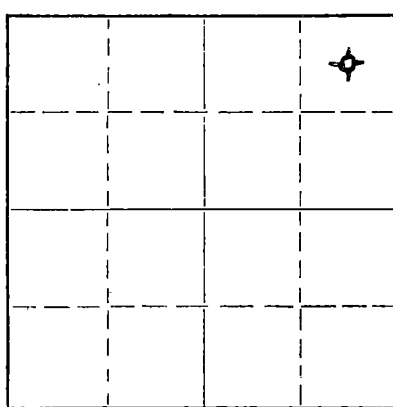

Locate well correctly on above Section Plat

Kiowa County, Sec. 9 Twp. 29S Rge. (E) 17 (W)
Location as "NE/CNW/SW" or footage from lines C NE NE
Lease Owner Jas. F. Smith
Lease Name Conklin Well No. 1-9
Office Address P. O. Box 10005, Amarillo, Texas
Character of Well (completed as Oil, Gas or Dry Hole) Dry Hole
Date well completed March 10, 19 64
Application for plugging filed March 11, 19 64
Application for plugging approved orally March 10, 19 64
Plugging commenced March 10, 19 64
Plugging completed March 10, 19 64
Reason for abandonment of well or producing formation Dry hole

If a producing well is abandoned, date of last production _____ 19 ____
Was permission obtained from the Conservation Division or its agents before plugging was commenced? Yes

Name of Conservation Agent who supervised plugging of this well Archie Elving, Pratt, Kansas
Producing formation None Depth to top _____ Bottom _____ Total Depth of Well 4838 Feet
Show depth and thickness of all water, oil and gas formations.

OIL, GAS OR WATER RECORDS

CASING RECORD

| FORMATION | CONTENT | FROM | TO | SIZE | PUT IN | PULLED OUT |
|---------------|---------|------|------|--------|--------|------------|
| Herington | Water | 2398 | | 8-5/8" | 400' | None |
| Heebner shale | | 4004 | 4008 | | | |
| Lansing | Water | 4192 | | | | |
| Marmaton | Water | 4546 | 4696 | | | |
| Cherokee | Dry | 4696 | 4748 | | | |
| Miss. Chat | Dry | 4748 | | | | |

Describe in detail the manner in which the well was plugged, indicating where the mud fluid was placed and the method or methods used in introducing it into the hole. If cement or other plugs were used, state the character of same and depth placed, from _____ feet to _____ feet for each plug set.

Plugged hole with 25 sacks common cement at 340 feet and 15 sacks common cement from 40 feet to surface.

RECEIVED
STATE CORPORATION COMMISSION

MAR 27 1964

CONSERVATION DIVISION
Wichita, Kansas

(If additional description is necessary, use BACK of this sheet)

Name of Plugging Contractor Tommy Ward Drilling Company
Address 609 Liberty Bank Building, Oklahoma City, Oklahoma

STATE OF TEXAS, COUNTY OF POTTER, ss.
Mark Williams (employee of owner ~~XXXXXX~~) of the above-described

well, being first duly sworn on oath, says: That I have knowledge of the facts, statements, and matters herein contained and the log of the above-described well as filed and that the same are true and correct. So help me God.

(Signature) Mark Williams

P. O. Box 10005, Amarillo, Texas
(Address)

SUBSCRIBED AND SWORN TO before me this 26th day of March, 19 64

Lucas Luty
Notary Public.

My commission expires June 1, 1965