


STATE OF KANSAS
STATE CORPORATION COMMISSION

WELL PLUGGING RECORD

Give All Information Completely
Make Required Affidavit
Mail or Deliver Report to
Conservation Division
State Corporation Comm.
245 North Water
Wichita, KS 67202

Kiowa County. Sec. 9 Twp. 29S Rge. 17 N/W
Location as "NE/CNW 1/4 SW 1/4" or footage from lines
C E/2 NE

Lease Owner Imperial Oil Company
Lease Name Conklin Well No. #1-9
Office Address 720 Fourth Financial Center, Wichita, Ks. 67202
Character of Well (Completed as Oil, Gas or Dry Hole) Dry Hole

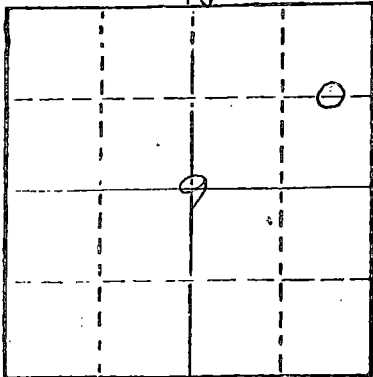

Locate well correctly on above
Section Plat

Date Well completed Sept. 22, 1978
Application for plugging filed (verbally) Sept. 22, 1978
Application for plugging approved (verbally) Sept. 22, 1978
Plugging commenced Sept. 22, 1978
Plugging completed Sept. 22, 1978

Reason for abandonment of well or producing formation No commercial quantity of oil or gas encountered
If a producing well is abandoned, date of last production 19

Was permission obtained from the Conservation Division or its agents before plugging was commenced? Yes

Name of Conservation Agent who supervised plugging of this well Bill Owens
Producing formation _____ Depth to top _____ Bottom _____ Total Depth of Well 4815'
Show depth and thickness of all water, oil and gas formations.

OIL, GAS OR WATER RECORDS

CASING RECORD

FORMATION	CONTENT	FROM	TO	SIZE	PUT IN	PULLED OUT

Describe in detail the manner in which the well was plugged, indicating where the mud fluid was placed and the method or methods used in introducing it into the hold. If cement or other plugs were used, state the character of same and depth placed, from _____ feet to _____ feet for each plug set.

Set 1st plug at 600' with 35 sacks
2nd plug at 410' with 35 sacks
3rd plug at 40' with 1/2 sack hulls, 12 sacks
rathole with 3 sacks
Cemented with 50-50 posmix, 6% gel

RECEIVED
STATE CORPORATION COMMISSION

SEP 29 1978

CONSERVATION DIVISION
Wichita, Kansas

9-29-1978

(If additional description is necessary, use BACK of this sheet)

Name of Plugging Contractor Abercrombie Drilling, Inc.

STATE OF KANSAS COUNTY OF SEDGWICK, ss.

Jack L. Partridge, Ass't. Secretary-Treasurer (employee of owner) or (owner or operator) of the above-described well, being first duly sworn on oath, says: That I have knowledge of the facts, statements, and matters herein contained and the log of the above-described well as filed and that the same are true and correct. So help me God.

(Signature)

801 Union Center, Wichita, Kansas 67202
(Address)

SUBSCRIBED AND SWORN TO before me this 27th day of September, 1978

Sandra Richman
Sandra Richman Notary Public.

My commission expires July 21, 1979



CONTRACTOR'S WELL LOG

OPERATOR: Imperial Oil Company
 CONTRACTOR: Abercrombie Drilling, Inc.
 WELL NAME: Conklin #1-9
 LOCATION: C E/2 NE Section 9-29S-17W
 Kiowa County, Kansas
 SPUD DATE: September 9, 1978.
 COMPLETION DATE: September 22, 1978

0	402	Sand, shells, clay & shale
402	2121	Shale
2121	2548	Lime & shale
2548	2930	Shale & lime
2930	3645	Lime & shale
3645	3730	Shale & lime
3730	3940	Lime & shale
3940	4009	Shale & lime
4009	4145	Lime & shale
4145	4384	Shale & lime
4384	4755	Lime & shale
4755	4815	Shale & lime
	4815	Rotary Total Depth

RECEIVED
 STATE CORPORATION COMMISSION

SAMPLE TOPS:

Anhydrite 1037'
 B/Anhydrite 1053'

SEP 29 1978

CONSERVATION DIVISION
 Wichita, Kansas

Spud hole at 10:15 a.m., September 9, 1978. Drilled 402' of 12 1/4" hole. Ran 10 joints of 8-5/8" - 24# casing. Set at 402' with 325 sacks common cement, 2% gel, 3% CaCl. Cement did circulate. Plug as down at 6:00 p.m., September 9, 1978.

T.D. 4815'. Set first plug at 600' with 35 sacks, second plug at 410' with 35 sacks, third plug at 40' with 1/2 sack hulls, 12 sacks cement, rathole with 3 sacks. Cemented with 50-50 posmix, 6% gel. Job was complete at 2:30 a.m., September 22, 1978. State Plugger - Bill Owens.

STATE OF KANSAS)
) ss
 COUNTY OF SEDGWICK)


Jack L. Partridge, Assistant Secretary-Treasurer of Abercrombie Drilling, Inc., does hereby state that the above and foregoing is a true and correct copy of the log of the Conklin #1-9, C E/2 NE Section 9-29S-17W, Kiowa County, Kansas.

ABERCROMBIE DRILLING, INC.

BY Jack L. Partridge
 Jack L. Partridge,
 Assistant Secretary-Treasurer

Subscribed and sworn to before me, a Notary Public, in and for the county and state aforesaid, as of this 27th day of September, 1978.

Sandra Richman
 Sandra Richman, Notary Public

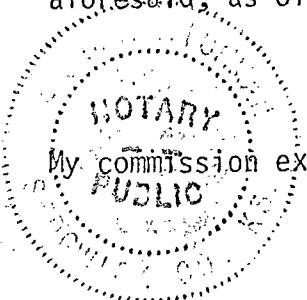

My commission expires July 21, 1979.