


STATE OF KANSAS
STATE CORPORATION COMMISSION

Give All Information Completely
Make Required Affidavit
Mail or Deliver Report to:
Conservation Division
State Corporation Commission
211 No. Broadway
Wichita, Kansas

WELL PLUGGING RECORD

NORTH

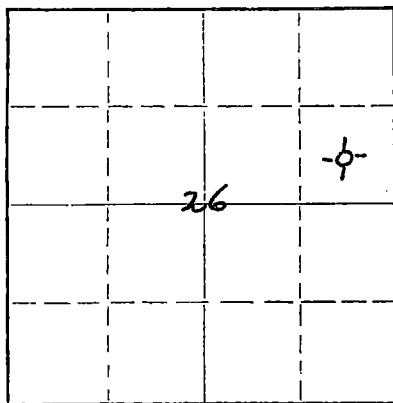

Locate well correctly on above
Section Plat

Pratt County. Sec. 26 Twp. 28S Rge. 15 (E) W (W)
Location as "NE/CNW/SW" or footage from lines C SE NE
Lease Owner D. R. Lauck Oil Company, Inc.
Lease Name Barbee Thompson Well No. 1
Office Address 301 S. Broadway Wichita, Kansas
Character of Well (completed as Oil, Gas or Dry Hole) ? Dry Hole
Date well completed April 19, 1961 19 61
Application for plugging filed April 19, 19 61
Application for plugging approved April 19 19 61
Plugging commenced April 19 19 61
Plugging completed April 19 19 61
Reason for abandonment of well or producing formation Dry Hole

If a producing well is abandoned, date of last production - 19 -
Was permission obtained from the Conservation Division or its agents before plugging was commenced? yes

Name of Conservation Agent who supervised plugging of this well W. L. Lackemp
Producing formation _____ Depth to top _____ Bottom _____ Total Depth of Well 4643 Feet
Show depth and thickness of all water, oil and gas formations.

OIL, GAS OR WATER RECORDS

CASING RECORD

| FORMATION | CONTENT | FROM | TO | SIZE | PUT IN | PULLED OUT |
|-----------|---------|------|-----|-------|--------|------------|
| | | 0 | 320 | 8 5/8 | 320' | none |
| | | | | | | |
| | | | | | | |
Describe in detail the manner in which the well was plugged, indicating where the mud fluid was placed and the method or methods used in introducing it into the hole. If cement or other plugs were used, state the character of same and depth placed, from _____ feet to _____ feet for each plug set.

Hole filled with mud 4643-300
Plug 300-296
cement 296- 35
Plug 35- 31
cement 31- 6 bottom of collar

RECEIVED
STATE CORPORATION COMMISSION

JUN 9 1961 00-09-61

CONSERVATION DIVISION
Wichita, Kansas

(If additional description is necessary, use BACK of this sheet)

Name of Plugging Contractor Sun Cementing Company
Address Great Bend, Kansas

STATE OF Kansas, COUNTY OF Sedwick, ss.
John H. Knightley (employee of owner) or (owner or operator) of the above-described well, being first duly sworn on oath, says: That I have knowledge of the facts, statements, and matters herein contained and the log of the above-described well as filed and that the same are true and correct. So help me God.

(Signature) John H. Knightley
John H. Knightley
301 S. Broadway, Wichita, Kansas
(Address)

SUBSCRIBED AND SWORN to before me this 31st day of May 1961

My commission expires Sept. 4, 1962

Helene S. Ramey
Helene S. Ramey Notary Public.



D. R. Lauck Oil Company, Inc.

Barbee Thompson #1

C SE NE Sec. 26-28S-15W
Pratt County Kansas

Commenced: April 15, 1961

Completed: April 19, 1961

Casing Record: 320' 8 5/8" Cemented with 215 sacks
Calcium Chloride 4 Sacks

Elevation: GR 2054; DF 2056; KB 2058

Drillers Log

| | |
|----------------|----------|
| Surface Clay | 75 |
| Sand | 274 |
| Shale & Shell | 290 |
| Red Bed | 575 |
| Red Rock | 935 |
| Anhydrite | 960 |
| Shaled Shells | 1570 |
| Shale & Shells | 2040 |
| Anhydrite | 2215 |
| Shale & Lime | 2330 |
| Lime | 2510 |
| Lime & Shale | 2685 |
| Lime | 2765 |
| Shale & Lime | 2925 |
| Lime | 3188 |
| Lime & Shale | 3310 |
| Shale & Lime | 3420 |
| Lime- | 3500 |
| Lime & Shale | 3625 |
| Lime | 3650 |
| Lime & Shale | 3735 |
| Lime | 3885 |
| Lime & Shale | 3942 |
| Lime | 4585 |
| Sand | 4620 |
| Lime | 4643 RTD |

Tops

| | | |
|----------------|-----------|-----------|
| Heebner | 3891-1833 | 3889-1831 |
| Torento | 3917-1859 | 3917-1859 |
| Douglas | 3948-1890 | 3948-1890 |
| Brown Lime | 4045-1987 | 4046-1988 |
| Lansing | 4064-2006 | 4064-2006 |
| Base KC | 4436-2378 | 4436-2378 |
| Cherokee Shale | 4537-2479 | 4537-2479 |
| Miss. | 4562-2504 | 4564-2506 |
| Kinderhook | | |
| Shale | 4574-2516 | 4574-2516 |
| Kinderhook | | |
| Sand | 4580-2522 | 4580-2522 |
| Viola | 4639-2581 | 2639-2581 |
| Rotary | | |
| Total Depth | 4643-2585 | 4643-2585 |

DST #1 4110-4135 Open 1 hour; Good
Blow 1 hour. Recovered 400' water.
ISIP 1469# 20 Min FSIP 1414# 20Min
IFP 44# FFP 201#

DST #2 (m) 4564-4575 Open 1 hour;
fair blow declining to weak blow
1 hour. Recovered 35' mud. ISIP 44#
20 Min. FSIP 33# 30 Min.
IFP 22# FFP 22#

DST#3 (m) 4582-4597 Open 1 hour
weak blow 2 1/2 min. flushed tool two
times, Recovered 140' mud. ISIP 0
20 Min FSIP 67# 30 Min IFP 11#
FFP 22#

D & A

RECEIVED
STATE CORPORATION COMMISSION

JUN 9 1961

CONSERVATION DIVISION
Wichita, Kansas