


STATE OF KANSAS
STATE CORPORATION COMMISSION

WELL PLUGGING RECORD

Give All Information Completely
Make Required Affidavit
Mail or Deliver Report to:
Conservation Division
State Corporation Commission
211 No. Broadway
Wichita, Kansas

Pratt County. Sec. 25 Twp. 28S Rge. 15 (E) (W)

Location as "NE/CNW%SW%" or footage from lines. SW/4 SW/4 SE/4
Lease Owner Twin Drilling, Inc.
Lease Name Johnson Well No. 1
Office Address 1005 Central Building, Wichita, Kansas
Character of Well (completed as Oil, Gas or Dry Hole) Dry Hole
Date well completed 7-8 1958
Application for plugging filed 7-16 1958
Application for plugging approved 7-18 1958
Plugging commenced 7-9 1958
Plugging completed 7-9 1958
Reason for abandonment of well or producing formation Dry Hole

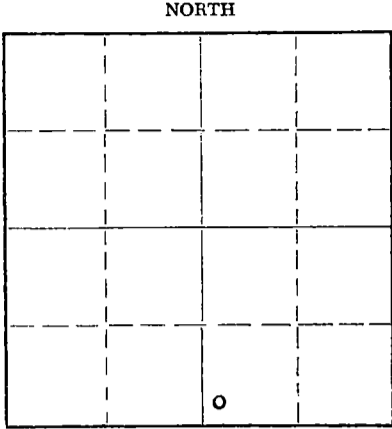

Locate well correctly on above
Section Plat

If a producing well is abandoned, date of last production 19
Was permission obtained from the Conservation Division or its agents before plugging was commenced? Yes

Name of Conservation Agent who supervised plugging of this well Mr. Frank Broadfoot
Producing formation _____ Depth to top _____ Bottom _____ Total Depth of Well 4840 Feet
Show depth and thickness of all water, oil and gas formations.

OIL, GAS OR WATER RECORDS

CASING RECORD

FORMATION	CONTENT	FROM	TO	SIZE	PUT IN	PULLED OUT
				8 5/8"	326.64'	

Describe in detail the manner in which the well was plugged, indicating where the mud fluid was placed and the method or methods used in introducing it into the hole. If cement or other plugs were used, state the character of same and depth placed, from _____ feet to _____ feet for each plug set.

Set bottom plug and 1/4 sack hulls at 240 with 20 sack cement through drill pipe. Top plug at 35' with 10 sacks cap.

REGISTERED
STATE OF KANSAS
WICHITA, KANSAS

07-23-58

WICHITA, KANSAS

(If additional description is necessary, use BACK of this sheet)

Name of Plugging Contractor Twin Drilling, Inc.
Address 1005 Central Building, Wichita, Kansas

STATE OF Kansas, COUNTY OF Sedgwick, ss.
Almeda Day (employee of owner) or (owner or operator) of the above-described well, being first duly sworn on oath, says: That I have knowledge of the facts, statements, and matters herein contained and the log of the above-described well as filed and that the same are true and correct. So help me, God.

(Signature) Almeda Day
1005 Central Building, Wichita, Kansas
(Address)

SUBSCRIBED AND SWORN TO before me this 16 day of July, 19 58

Esther B. Meyer Notary Public.

My commission expires Oct. 3, 1961

PLUGGING
FILE SEC 25 T. 28 R 15W
BOOK PAGE 116 LI E3

WELL LOG

Well: Johnson #1
Location: SW/4 SW/4 SE/4
Section 25-28S-15W
Pratt County, Kansas
Elevation: 2045 G.R.
Casing: 326.64' 8 5/8" Surface
Cemented W/175 Sax

Contractor: Twin Drilling, Inc.
1005 Central Building
Wichita, Kansas
Operator: Same
Commenced: 6-23-58
Completed: 7- 8-58

Surface 49
Sand 200
Soft shale 260
Shells-shale 300
Clay & shale 320
Shale & red bed 548
Shale & lime shells 1552
Lime-shale 2060
Lime 2125
Ft. Riley lime 2288
Lime 2445
Shale & lime 2580
Lime W/shale breaks 2808
Lime-shale 3390
Lime 3330
Shale-lime 3607
Lime 3882
Lime W/shale breaks 3955
Lime-shale 4075
Lime 4180
K.C. Lime 4239
Lime 4555
Lime sand chert 4607
Lime 4620
Lime chert-shale 4663
Lime 4692
Shale & Lime 4724
Sand 4745
Sand & shale 4787
Arbuckle 4840
Rotary T.D. 4840

Tops:
Heebner 3878
Brown lime 4035
Lansing 4050
Base K.C. 4440
Miss. chert 4535
Kinderhook 4550
Viola 4614
Simpson 4696
Arbuckle 4804

STATE OF KANSAS)
) ss
COUNTY OF SEDGWICK)

The undersigned, TWIN DRILLING, INC., hereby certifies that the above log is a true and correct log of the formations encountered in drilling the above well as reflected by the Daily Drilling Report.

TWIN DRILLING, INC.

By Alfred May

Subscribed and sworn to before me
this 16th day of July, 1958.

James A. Hicks
Notary Public

My commission expires
September 29, 1960.

PLUGGING
FILE: SEC 25 T 28 R 15W
BOOK PAGE 116 LINE 3