


STATE OF KANSAS  
STATE CORPORATION COMMISSION

WELL PLUGGING RECORD

Give All Information Completely  
Make Required Affidavit  
Mail or Deliver Report to  
Conservation Division  
State Corporation Comm.  
245 North Water  
Wichita, KS 67202

Pratt County. Sec. 25 Twp. 28S Rge. 15W 1/2/1/2  
Location as "NE/CNW 1/4 SW 1/4" or footage from lines C NE/4 SW/4  
Lease Owner Cities Service Company  
Lease Name Cook "H" Well No. 1  
Office Address 700 Sutton Place Bldg., Wichita, Ks. 67202  
Character of Well (Completed as Oil, Gas or Dry Hole) D & A  
Date Well completed March 31, 19 80  
Application for plugging filed March 31, 19 80  
Application for plugging approved March 31, 19 80  
Plugging commenced April 1, 19 80  
Plugging completed April 1, 19 80  
Reason for abandonment of well or producing formation D & A  
If a producing well is abandoned, date of last production 19

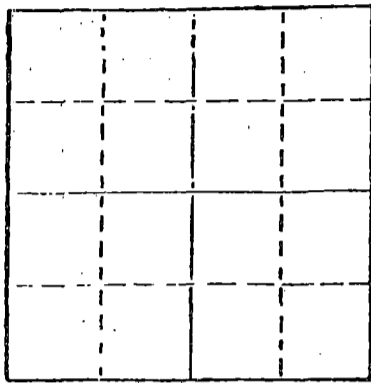

Locate well correctly on above Section Plat

Was permission obtained from the Conservation Division or its agents before plugging was commenced? Yes

Name of Conservation Agent who supervised plugging of this well Wm. T. Owen  
Producing formation \_\_\_\_\_ Depth to top \_\_\_\_\_ Bottom \_\_\_\_\_ Total Depth of Well 3,600'  
Show depth and thickness of all water, oil and gas formations.


OIL, GAS OR WATER RECORDS

CASING RECORD

FORMATION	CONTENT	FROM	TO	SIZE	PUT IN	PULLED OUT
				8 5/8"	363'	-0-

Describe in detail the manner in which the well was plugged, indicating where the mud fluid was placed and the method or methods used in introducing it into the hold. If cement or other plugs were used, state the character of same and depth placed, from \_\_\_\_\_ feet to \_\_\_\_\_ feet for each plug set.

Plugged hole @ 540' w/35 sx cement  
@ 360' w/25 sx cement  
@ 40' w/10 sx cement  
5 sx cement in rathole

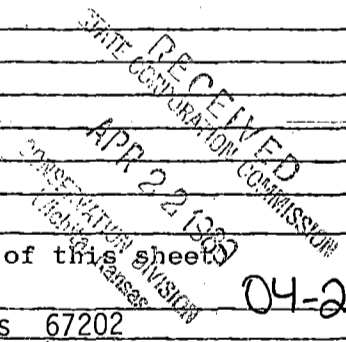

(If additional description is necessary, use BACK of this sheet)

Name of Plugging Contractor Red Tiger Drilling Company  
1720 KSB&T Building, Wichita, Kansas 67202

STATE OF Kansas COUNTY OF Sedgwick, ss. contractor  
Gloria Fawcett (employee of ~~xxxxxxx~~)

of the above-described well, being first duly sworn on oath, says: That I have knowledge of the facts, statements, and matters herein contained and the log of the above-described well as filed and that the same are true and correct. So help me God.

(Signature) Gloria Fawcett  
1720 KSB&T Building, Wichita, Kansas 67202  
(Address)

SUBSCRIBED AND SWORN TO before me this 10th day of April, 19 80.

Joyce A. Hagermann  
Notary Public.

My commission expires \_\_\_\_\_

