

STATE OF KANSAS
STATE CORPORATION COMMISSION

Form CP-4


WELL PLUGGING RECORD

Give All Information Completely
Make Required Affidavit
Mail or Deliver Report to:
Conservation Division
State Corporation Commission
212 No. Market
Wichita, Kansas

Pratt County. Sec. 25 Twp. 28 Rge. (E) 15 (W)

Location as "NE/CNW/SW" or footage from lines. C SE SW
Lease Owner. Misco Leasing, Inc.
Lease Name. Cook Well No. 1
Office Address. 101 Misco Bldg., Wichita, Kansas 67202
Character of Well (completed as Oil, Gas or Dry Hole) Oil and Gas
Date well completed. September 25, 19 64
Application for plugging filed. February 14, 19 68
Application for plugging approved. February 14, 19 68
Plugging commenced. 2-15 1968
Plugging completed. 2-17 19 68
Reason for abandonment of well or producing formation. Non-Production

NORTH

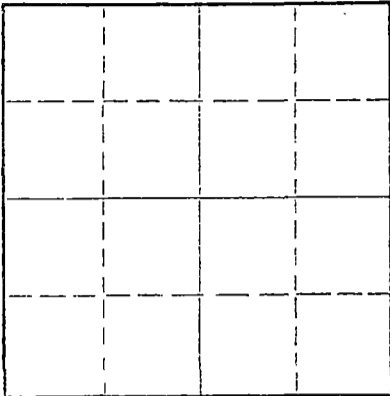

Locate well correctly on above
Section Plat

If a producing well is abandoned, date of last production. 19
Was permission obtained from the Conservation Division or its agents before plugging was commenced? Yes

Name of Conservation Agent who supervised plugging of this well. Archie Elving
Producing formation. Depth to top. Bottom. Total Depth of Well. 4748 Feet
Show depth and thickness of all water, oil and gas formations.

OIL, GAS OR WATER RECORDS

CASING RECORD

FORMATION	CONTENT	FROM	TO	SIZE	PUT IN	PULLED OUT
				4 1/2	4610	3263
				8 3/8	325	none

Describe in detail the manner in which the well was plugged, indicating where the mud fluid was placed and the method or methods used in introducing it into the hole. If cement or other plugs were used, state the character of same and depth placed, from feet to feet for each plug set.

Howco pumped 100 sax cement with plug to 4003ft.- pulled 3263ft. 4 1/2" pipe - mud hole to 280ft.- 10ft. rock bridge to 270ft.- dump 4 yds. ready mix cement to surface.

RECEIVED
STATE CORPORATION COMMISSION
FEB 28 1968
CONSERVATION DIVISION
Wichita, Kansas

(If additional description is necessary, use BACK of this sheet)

Name of Plugging Contractor. Ralph Comstock Pipe Pulling, Inc. Permit #490
Address. 320 N. Park, Stafford, Kansas

STATE OF KANSAS, COUNTY OF SEDGWICK, ss.

(employee of owner) or (owner or operator) of the above-described well, being first duly sworn on oath, says: That I have knowledge of the facts, statements, and matters herein contained and the log of the above-described well as filed and that the same are true and correct. So help me God. MISCO LEASING, INC.

(Signature) By Melvin Panbock C.A.M.B.R.

WICHITA, KANSAS (Address)

SUBSCRIBED AND SWORN to before me this 27th day of FEBRUARY, 19 68

Leona M. Houston

Notary Public.

