

STATE OF KANSAS
STATE CORPORATION COMMISSION

WELL PLUGGING RECORD

Give All Information Completely
Make Required Affidavit
Mail or Deliver Report to
Conservation Division
State Corporation Comm.
245 North Water
Wichita, KS 67202

Pratt County, Sec. 24 Twp. 28S Rge. 15W 1/4/W
Location as "NE/CNW 1/4 SW 1/4" or footage from lines
C S/2 NE/4


Lease Owner Imperial Oil Company
Lease Name Berry Well No. I-24
Office Address 720 Fourth Financial Center, Wichita, Ks. 67202
Character of Well (Completed as Oil, Gas or Dry Hole) D & A

Date Well completed November 17, 1980
Application for plugging filed November 17, 1980
Application for plugging approved November 17, 1980
Plugging commenced November 17, 1980
Plugging completed November 17, 1980

Reason for abandonment of well or producing formation D & A
If a producing well is abandoned, date of last production 19

Was permission obtained from the Conservation Division or its agents before plugging was commenced? Yes

Name of Conservation Agent who supervised plugging of this well Wm. T. Owen
Producing formation Depth to top Bottom Total Depth of Well 4,760'
Show depth and thickness of all water, oil and gas formations.

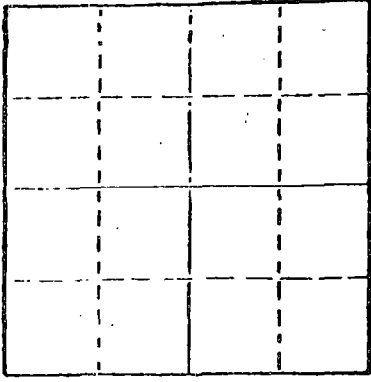

Locate well correctly on above Section Plat

OIL, GAS OR WATER RECORDS

CASING RECORD

FORMATION	CONTENT	FROM	TO	SIZE	PUT IN	PULLED OUT
				8 5/8"	400'	-0-

Describe in detail the manner in which the well was plugged, indicating where the mud fluid was placed and the method or methods used in introducing it into the hold. If cement or other plugs were used, state the character of same and depth placed, from feet to feet for each plug set.

Plugged hole @ 450' w/60 sx cement
@ 40' w/10 sx cement
10 sx cement in rathole
50-50 Pozmix, 4% Gel, 3% C.C.

(If additional description is necessary, use BACK of this sheet)

Name of Plugging Contractor Red Tiger Drilling Company
1720 KSB&T Building, Wichita, Kansas 67202

11-25-80
RECEIVED
NOV 25 1980

STATE OF Kansas COUNTY OF Sedgwick, ss. contractor
Gloria Fawcett (employee of ~~owner~~ ~~owner~~ ~~operator~~)
of the above-described well, being first duly sworn on oath, says: That I have knowledge of the facts, statements, and matters herein contained and the log of the above-described well as filed and that the same are true and correct. So help me God.

(Signature) Gloria Fawcett
1720 KSB&T Building, Wichita, Kansas 67202
(Address)

SUBSCRIBED AND SWORN TO before me this 21st day of November, 1980.

Joyce A. Baer
Notary Public.

My commission expires



DRILLERS LOG

No. 1-24 Berry

CASING RECORD:	COMPANY:	Imperial Oil Company	DESCRIPTION:
8 5/8" @ 415' w/300 sx cement	CONTRACTOR:	Red Tiger Drilling Company	C S/2 NE/4 Sec. 24-T28S-R15W Pratt County, Kansas
D & A	COMMENCED:	November 5, 1980	
TOTAL DEPTH: 4,760'	COMPLETED:	November 17, 1980	ELEVATION: 2,053' GR

<u>FORMATION</u>	<u>FROM</u>	<u>TO</u>	<u>REMARKS</u>
Surface Soil	0	417	
Shale	417	2775	
Shale & Lime	2775	3760	
Sand & Shale	3760	3925	
Shale & Lime	3925	4060	
Shale	4060	4230	
Lime	4230	4760	
RTD		4760	

I certify that this is a true and correct copy of the above log to the best of my knowledge.

RED TIGER DRILLING COMPANY

Gloria Fawcett
Gloria Fawcett

Subscribed and sworn to before me this 21st day of November, 1980.

Joyce A. Baer
Notary Public

