


STATE OF OKLAHOMA
STATE CORPORATION COMMISSION

Give All Information Completely
Make Required Affidavit
Mail or Deliver Report to:
Conservation Division
State Corporation Commission
800 Bittling Building
Wichita, Kansas

WELL PLUGGING RECORD

NORTH

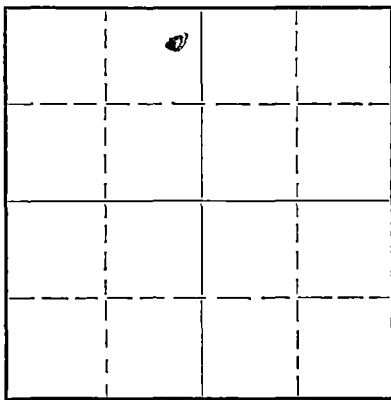

Locate well correctly on above
Section Plat

Pratt County, Sec. 22 Twp. 28 Rge. 15 (E) (W)
Location as "NE/CNW 1/4 SW 1/4" or footage from lines ~~Center~~ NE NE NW
Lease Owner Flynn Oil Company
Lease Name Thompson Well No. 1
Office Address Utica National Bank Bldg., Tulsa, Okla.
Character of Well (completed as Oil, Gas or Dry Hole) dry hole
Date well completed 6-17 1953
Application for plugging filed 6-17 1953
Application for plugging approved 6-17 1953
Plugging commenced 6-17 1953
Plugging completed 6-17 1953
Reason for abandonment of well or producing formation dry hole

If a producing well is abandoned, date of last production 19
Was permission obtained from the Conservation Division or its agents before plugging was commenced? yes

Name of Conservation Agent who supervised plugging of this well Merle Rives
Producing formation Depth to top Bottom Total Depth of Well 4875 Feet
Show depth and thickness of all water, oil and gas formations.

OIL, GAS OR WATER RECORDS

CASING RECORD

Formation	Content	From	To	Size	Put In	Pulled Out
		0'	289'	8-5/8"	288'	

Describe in detail the manner in which the well was plugged, indicating where the mud fluid was placed and the method or methods used in introducing it into the hole. If cement or other plugs were used, state the character of same and depth placed, from feet to feet for each plug set.

Filled hole up to 280' with mud - put first at 280' - 1/3 sack of hulls ahead of plug and 20 sacks of cement through drill pipe on top of plug. Filled hole to 40' set #2 plug - 1/3 sack of hulls ahead of plug - 10 sacks of cement on top of plug. Filled up to 3' of ground level.

RECEIVED
STATE CORPORATION COMMISSION
JUN 24 1953
6-24-1953
CONSERVATION DIVISION
Wichita, Kansas

(If additional description is necessary, use BACK of this sheet)

Correspondence regarding this well should be addressed to Flynn Oil Company
Address Utica National Bank Bldg., Tulsa, Okla.

STATE OF Oklahoma, COUNTY OF Tulsa, ss.

A. M. Barbour (employee or owner) or (owner or operator) of the above-described well, being first duly sworn on oath, says: That I have knowledge of the facts, statements, and matters herein contained and the log of the above-described well as filed and that the same are true and correct. So help me God. BARBOUR DRILLING COMPANY

(Signature) *A. M. Barbour*

717 First National Bldg., Tulsa, Okla.
(Address)

SUBSCRIBED AND SWORN to before me this 22nd day of June, 1953.

Merry Jane Burt
Notary Public.

My commission expires July 27, 1953

23-5091-5 8-50-10M
PLUGGING
FILE SEC 22 T 28 R 15W
BOOK PAGE 109 9

THOMPSON NO. 1
~~CENTER-NW~~ SECTION 22-28-15
 PRATT COUNTY, KANSAS
 FLYNN OIL COMPANY

8-5/8" O. D. casing cemented at 289'

Drilling commenced May 24, 1953
 Drilling completed June 17, 1953

FROM	TO	FORMATION	REMARKS
0'	65'	Surface clay & shale	
65'	252'	Sand	
252'	289'	Red bed & shale	8-5/8" O. D. casing cemented with 200 sacks bulk cement at 289'
289'	685'	Shale	
685'	924'	Shale & shells	
924'	944'	Lime	
944'	1800'	Shale & shells	
1800'	2025'	Shale	
2025'	2280'	Lime & shale	
2280'	2375'	Shale & lime	
2375'	2565'	Lime & shale	
2565'	2755'	Shale & lime	
2755'	2955'	Lime & shale	
2955'	3035'	Shale & lime	
3035'	3180'	Shale & shells	
3180'	3265'	Shale & lime	
3265'	3330'	Shale & shells	
3330'	3400'	Lime & shale	
3400'	3470'	Lime & shale breaks	
3470'	3514'	Shale & lime	
3514'	3620'	Lime	
3620'	3710'	Lime & shale breaks	
3710'	3780'	Shale & lime	
3780'	3845'	Lime	
3845'	3930'	Lime & shale breaks	
3930'	4020'	Lime & shale	
4020'	4175'	Lime	
4175'	4210'	Lime & shale	
4210'	4430'	Lime	
4430'	4490'	Lime & shale	
4490'	4530'	Shale & lime	
4530'	4560'	Lime & shale	
4560'	4590'	Lime	
4590'	4610'	Cherty lime	

THOMPSON NO. 1
 22-28-15
 109 LINE-9

RECEIVED
 STATE CORPORATION COMMISSION
 JUN 24 1953
 CONSERVATION DIVISION
 WICHITA, KANSAS

FROM	TO	FORMATION	REMARKS
4610	4630	Lime, cherty	
4630	4650	Lime	
4650	4685	Cherty lime	
4685	4755	Lime	
4755	4840	Shale & lime	
4840	4875	Lime	Dry hole - well plugged
T.D.	4875'		

This is a true copy of the driller's log as shown on the drilling tickets.

BARBOUR DRILLING COMPANY

By *M. Barbour*

Subscribed and sworn to before me on this 22nd day of June, 1953.

Merry Jane Burt
Notary Public

My commission expires: July 27, 1953

