


Give All Information Completely
Make Required Affidavit
Mail or Deliver Report to:
Conservation Division
State Corporation Commission
211 No. Broadway
Wichita, Kansas

WELL PLUGGING RECORD

Pratt County, Sec. 22 Twp. 28 Rge. 15 (E) (W) X

Location as "NE/CNW/SW" or footage from lines NE NE NW
Lease Owner J. E. Newman
Lease Name Thompson Well No. 1
Office Address Suite 2005 Tower Bldg. Denver, Colorado
Character of Well (completed as Oil, Gas or Dry Hole) Dry Hole
Date well completed February 15 19 61
Application for plugging filed May 4, 19 63
Application for plugging approved 19
Plugging commenced May 4, 19 63
Plugging completed May 4, (6:00pm) 19 63
Reason for abandonment of well or producing formation Dry Hole

NORTH

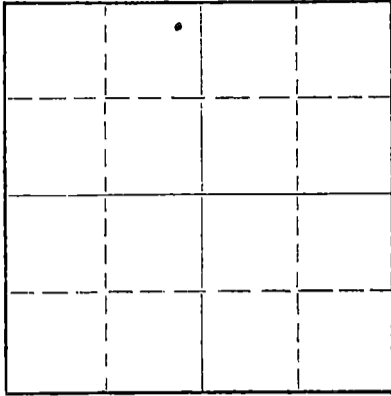

Locate well correctly on above Section Plat

If a producing well is abandoned, date of last production none 19
Was permission obtained from the Conservation Division or its agents before plugging was commenced? Yes

Name of Conservation Agent who supervised plugging of this well Archie Elving, Pratt, Kansas
Producing formation Cherokee Sand Depth to top 4528 Bottom 4533 Total Depth of Well 4576 Feet
Show depth and thickness of all water, oil and gas formations.

OIL, GAS OR WATER RECORDS

CASING RECORD

FORMATION	CONTENT	FROM	TO	SIZE	PUT IN	PULLED OUT
				5 1/2", 14#	4574	2810
NOTE: Electric Log was filed with the plugging application.						

Describe in detail the manner in which the well was plugged, indicating where the mud fluid was placed and the method or methods used in introducing it into the hole. If cement or other plugs were used, state the character of same and depth placed, from _____ feet to _____ feet for each plug set.

Plugged back to 4545'. Perforated from 4528' to 4533'. Sand and rock bridge to 4501', cemented with 6 sacks. Fluid level was up in hole. Plug was set at 225', 10' rock bridge, and 20 sacks cement. Hole was filled with mud to 40', 10' rock bridge, cemented with 10 sacks to base of the cellar. 2810' of 5 1/2" long string recovered from hole.

I hereby certify that the above well was plugged as hereing stated.

RECEIVED
STATE CORPORATION COMMISSION

MAY 21 1963

CONSERVATION DIVISION
Wichita, Kansas

(If additional description is necessary, use BACK of this sheet)

Name of Plugging Contractor Cherokee Drilling and Exploration Company, Inc.
Address Suite 2005 Tower Building, Denver U. S. National Center, Denver, Colo.

STATE OF Kansas, COUNTY OF Pratt, ss.
B. Y. Newman (employee of owner) or (owner or operator) of the above-described well, being first duly sworn on oath, says: That I have knowledge of the facts, statements, and matters herein contained and the log of the above-described well as filed and that the same are true and correct. So help me God.

(Signature) B. Y. Newman
1500 East 1st Pratt, Kan.
(Address)

SUBSCRIBED AND SWORN TO before me this 11th day of May, 1963
Janara L. Halzman
Notary Public.

My commission expires February 15, 1967

