


STATE OF KANSAS  
STATE CORPORATION COMMISSION  
CONSERVATION DIVISION  
P. O. BOX 17027  
WICHITA, KANSAS 67217

FORM CP-4

WELL PLUGGING RECORD

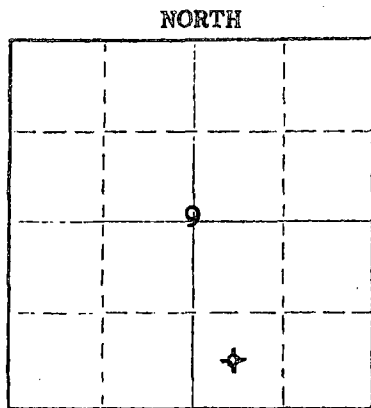

Pratt County, Sec. 9 Twp. 29S Rge. 11W (W)  
Location as "NE/CNW/SE" or footage from lines \_\_\_\_\_  
Lease Owner Kansas Petroleum, Inc.  
Lease Name Jackson "A" Well No. 1  
Office Address 500 Insurance Building, Wichita, Kansas  
Character of Well (completed as Oil, Gas or Dry Hole) Dry Hole  
Date well completed April 11, 1978  
Application for plugging filed April 11, 1978  
Application for plugging approved April 11, 1978  
Plugging commenced April 11, 1978  
Plugging completed April 11, 1978  
Reason for abandonment of well or producing formation Dry Hole

If a producing well is abandoned, date of last production \_\_\_\_\_ 19\_\_\_\_  
Was permission obtained from the Conservation Division or its agents before plugging was commenced? \_\_\_\_\_

Name of Conservation Agent who supervised plugging of this well \_\_\_\_\_  
Producing formation \_\_\_\_\_ Depth to top \_\_\_\_\_ Bottom \_\_\_\_\_ Total Depth of Well 3110 Feet  
Show depth and thickness of all water, oil and gas formations.

OIL, GAS OR WATER RECORDS

CASING RECORD

FORMATION	CONTENT	FROM	TO	SIZE	PUT IN	PULLED OUT
		0	300'	8-5/8"	291.13'	None

RECEIVED  
STATE CORPORATION COMMISSION

APR 17 1978

CONSERVATION DIVISION  
Wichita, Kansas

Describe in detail the manner in which well was plugged, indicating where the mud fluid was placed and the method or methods used in introducing it into the hole. If cement or other plugs were used, state the character of same and depth placed, from \_\_\_\_\_ feet to \_\_\_\_\_ feet for each plug set.

Plugged with 40 sacks cement at 540',  
30 sacks cement at 300', solid bridge plug  
and 12 sacks cement at 40'.

(If additional description is necessary, use BACK of this sheet)

Name of Plugging Contractor Halliburton Cementing Co.  
Address 410 Union Center, Wichita, Kansas 67202

STATE OF KANSAS, COUNTY OF SEDGWICK, ss.  
John D. Knightley, Agent (employee of owner) or (owner or operator) of the above-described well, being first duly sworn on oath, says: That I have knowledge of the facts, statements, and matters herein contained and the log of the above-described well as filed and that the same are true and correct. So help me God.

(Signature) [Signature]  
221 S. Broadway, Wichita, Kansas  
(Address)

SUBSCRIBED AND SWORN to before me this 14th day of April, 19 78

My commission expires March 12, 1979

[Signature]  
Notary Public.

Kansas Petroleum, Inc. - Jackson "A" #1  
C SW SE Sec. 9-29-11W  
Pratt County, Kansas

Contractor: D. R. Lauck Oil Company, Inc.  
221 S. Broadway, Suite 400  
Wichita, Kansas 67202

Commenced: April 7, 1978  
Completed: April 11, 1978

Drillers Log

Clay	85
Sand	170
Red Bed	930
Shale	1350
Shale & Shells	1905
Shale	2205
Shale & Shells	3020
Lime	3110 RTD

RECEIVED  
STATE CORPORATION COMMISSION  
APR 17 1978

Wichita, Kansas