

15-51-10017-00-60

STATE OF KANSAS
STATE CORPORATION COMMISSION

WELL PLUGGING RECORD

OR

Give All Information Completely
Make Required Affidavit
Mail or Deliver Report to
Conservation Division,
State Corporation Commission,
800 Bittling Building,
Wichita, Kansas.

RECEIVED
DEC 5 1936
Ka

FORMATION PLUGGING RECORD

Strike out upper line
when reporting plugging
of formations.

Pratt County, Sec. 5 Twp. 29S Rge. ~~EX~~ 11 (W)

Locate well correctly on above
640 A. Plat

Lease Name John Bolt
 Lease Owner Indian Territory Illuminating Oil Company
 Office Address Box 1251, Bartlesville, Oklahoma
 Character of Well (Oil, Gas or Dry) Dry Total Depth of Well 4597 Feet
 Date, well, completed November 10, 1936
 Application for plugging and log of well filed November 12 1936
 Application for plugging approved Verbal Permission Nov. 12 1936
 Plugging Commenced Nov. 12 1936
 Plugging Completed Nov. 14 1936
 Reason for abandonment of well or producing formation Dry Hole

If a producing well is abandoned, date of last production - 193-

Was permission obtained from the Conservation Division or its agents before plugging was commenced? Yes

Name of Conservation Officer who supervised plugging of this well Mr. C. T. Alexander
Producing formation None Depth to top - Bottom -

Show depth and thickness of all water, oil and gas formations.

OIL, GAS OR WATER RECORDS

CASING RECORD

Formation	Content	From	To	Size	Put In	Pulled Out
Chat	Show of Oil	4180		12 1/2"	325'	None
				8 5/8"	3757'	3100'
				7"	4402'	4402'

Describe in detail the manner in which the well was plugged, indicating where the mud fluid was placed and the method or methods used in introducing it into the hole. If cement or other plugs were used, state the character of same and depth placed, from _____ feet to _____ feet for each plug set.

Dumped cement from 4597' to 4550'. Filled with heavy mud to 4450'. Dumped 4 sacks cement. Pulled 7" casing. Mudded hole to 3100'. Bursted 8 5/8" casing off at 3100'. Started pipe and mudded hole as pipe was being pulled up to 320'. Dumped 15 sacks cement. Filled with mud to 15' and then with cement to surface

PLUGGING
FILE NO. 5-29-11W
BOOK PAGE 69-19

(If additional description is necessary use BACK of this sheet)

Does the above conform strictly to the Conservation Division regulations? Yes

Was exception made? None If so describe -

Correspondence regarding this well should be addressed to F. E. Turner
Address c/o Indian Territory Illuminating Oil Co., Bartlesville, Oklahoma.

STATE OF Oklahoma, COUNTY OF Washington, ss.

F. E. Turner (employee of owner) or (owner or operator) of the above-described well, being first duly sworn on oath, says: That I have knowledge of the facts, statements, and matters herein contained and the log of the above-described well as filed and that the same are true and correct. So help me God.


(Signature) [Signature]
Box 1251, Bartlesville, Oklahoma
(Address)

SUBSCRIBED AND SWORN to before me this 1st day of December, 1936

My commission expires January 20, 1938
J. C. Williamson
Notary Public.

WELL LOG

State Kansas Co. Pratt Farm John Bolt NE 1-4 5 Twp. 29S Rge. 11W

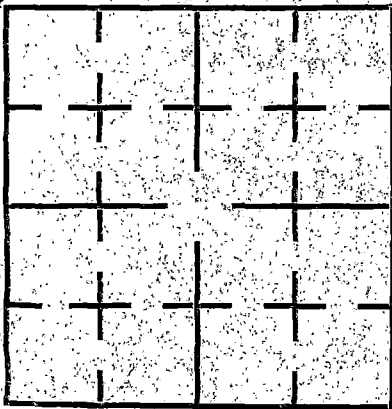

Location 660' S. of N. and 1980' W. of E. Line NE 1/4 Well No. 1

Lessee _____ Operator I.T.I.O. Co.

Date Location Made _____ By _____

Drilling Commenced 8-12-36 Drilling Completed 11-10-36

Drilling Contractor Olson Drilling Co.

Method of Drilling Rotary and Cable Elevation 1818' Total Depth 4597'

Commenced Producing Dry I. P. First 24 Hr.

Gravity _____ °Baume _____ Per Cent Water _____ Color _____ Water _____

Gas From _____ ft. to _____ ft. I.O.F., M. cu. ft. _____ R.P. lbs. _____

Gas From _____ ft. to _____ ft. I.O.F., M. cu. ft. _____ R.P. lbs. _____

Casing Record			Left in Hole			Shot Record		
Landed at	Size Ins.	Wt. per ft.	Length	From	To	Date	Quarts	Shot Between
325'	12 1/2"		325'	0	325'			Ft. and Ft.
3757'	8 5/8"		657	3100	3757			Ft. and Ft.
4402'	7"		None					Ft. and Ft.
						Remarks: (Methods used in protecting all oil and gas sands from top and bottom water.) Plugging completed 11-14-36		

FORMATION RECORD

0	20	Surface, Sandy	3445	3480	Lime
20	148	Sand, white	3480	3600	Broken Lime
148	185	Sand Rock, Red	3600	3652	Lime and Shale
185	700	Red Rock - 12 1/2" csg. Cemented at 325' W/250 sacks	3652	3655	Lime
700	750	Shale, Blue and Red	3655	3692	Lime and Shale
750	870	Red Beds	3692	3725	Shale
870	900	Shale, Gray	3725	3729	Lime
900	1040	Broken Shale	3729	3755	Shale
1040	1147	Shale, Black and Gray	3755	3774	Lime - Cemented 6 5/8" Csg. at 3757' W/50 Sacks
1147	1260	Shale, Blue	3774	3776	Pyrite and Lime, hard, H.F.W.
1260	1345	Shale, White and Blue	3776	3785	Lime, White, hard
1345	1464	Broken Shale	3785	3790	Lime, Gray
1464	1609	Shale, Blue	3790	3826	Lime
1609	1683	Anhydrite	3826	3837	Shale
1683	2100	Lime and Shale	3837	3864	Lime
2100	2120	Lime, Soft	3864	3870	Shale
2120	2180	Lime, Hard	3870	3928	Lime
2180	2283	Lime	3928	3934	Shale
2283	2488	Lime and Shale	3934	3941	Lime, Brown, Hard
2488	2500	Lime, Soft	3941	3945	Shale, Black
2500	2553	Lime and Shale	3945	3968	Lime, White
2553	2664	Broken Shale	3968	3976	Shale
2664	2925	Lime and Shale	3976	3984	Lime, Gray
2925	2981	Broken Lime and Shale	3984	3988	Lime, Brown
2981	3086	Lime W/Shale Breaks	3988	4000	Lime
3086	3118	Lime and Shale, Soft	4000	4006	Lime, Gray, Hard
3118	3157	Lime and Shale, Gray	4006	4016	Lime
3157	3194	Lime	4016	4023	Lime, Gray, Hard
3194	3312	Lime and Shale, Soft	4023	4031	Lime
3312	3325	Lime	4031	4037	Lime, Gray
3325	3430	Broken Lime	4037	4041	Shale
3430	3445	Lime, Soft			

PLUGGING

FILE NO. 5-29-11W

BOOK PAGE 49-19

Copied by _____ Checked _____

Lessee

John Bolt

Operator

I.T.I.O.

Farm

John Bolt

Well No.

1

FORMATION RECORD

Depth corrected by sand line from
4041' to 4031'

4031	4039	Broken Lime
4039	4054	Lime
4054	4056	Shale
4056	4060	Lime, Brown
4060	4065	Lime
4065	4068	Shale - Set 7" Csg. at 4068'
4068	4118	Lime
4118	4123	Lime, Brown
4123	4142	Shale, variegated
4142	4152	Shale and Shells
4152	4155	Lime, Brown
4155	4159	Shale, Variegated
4159	4164	Shale and Shells
4164	4174	Shale and Broken Lime
4174	4176	Shale
4176	4225	Chat - Show of oil at 4180'
4225	4233	Shale
4233	4255	Lime
4255	4383	Shale
4383	4410	Viola Lime - U. R. 7" csg. to 4402'
4410	4464	Lime, Brown
4464	4474	Lime, White
4474	4484	Shale, Green
4484	4486	Wilcox Sand
4486	4528	Sand - 3500' water in hole
4528	4546	Shale
4546	4548	Dolomite
4548	4579	Shale
4579	4585	Siliceous Lime, gray, hard
4585	4586	Siliceous Lime, gray - green
4586	4587	Siliceous Lime, gray, hard
4587	4597	Lime
	4597	Total Depth.

