


STATE OF KANSAS  
STATE CORPORATION COMMISSION  
CONSERVATION DIVISION  
P. O. BOX 17027  
WICHITA, KANSAS 67217

FORM CP-4

WELL PLUGGING RECORD

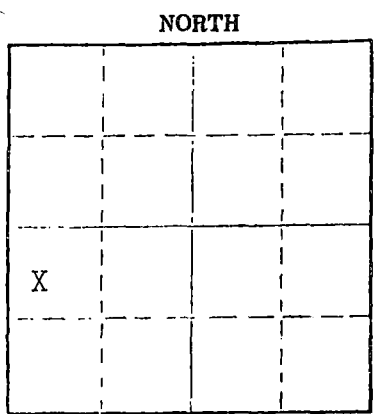

Locate well correctly on above Section Plot

Gray County, Sec. 31 Twp. 29S Rge. (E) 30 (W)  
Location as "NE/CNWxSWx" or footage from lines NW/4 SW/4  
Lease Owner Northern Natural Gas Co.  
Lease Name Woodson Well No. 1-31  
Office Address Box 872 - Woodward, OK 73801  
Character of Well (completed as Oil, Gas or Dry Hole)  
Date well completed 19  
Application for plugging filed 19  
Application for plugging approved 19  
Plugging commenced 12-26 1979  
Plugging completed 12-29 1979  
Reason for abandonment of well or producing formation

If a producing well is abandoned, date of last production 19  
Was permission obtained from the Conservation Division or its agents before plugging was commenced? yes

Name of Conservation Agent who supervised plugging of this well Clarence Thomas  
Producing formation Depth to top Bottom Total Depth of Well 5664'  
Show depth and thickness of all water, oil and gas formations.

OIL, GAS OR WATER RECORDS

CASING RECORD


FORMATION	CONTENT	FROM	TO	SIZE	PUT IN	PULLED OUT
				4 1/2"	3483'	2242'
				8 5/8"	806'	None

Describe in detail the manner in which the well was plugged, indicating where the mud fluid was placed and the method or methods used in introducing it into the hole. If cement or other plugs were used, state the character of same and depth placed, from feet to feet for each plug set.

12-27-79. Pumped 10 sacks of cement from 2450'-2350'.  
12-28-79. Pumped 35 sacks of cement from 756'-856'.  
12-29-79. Capped well with 15 sacks of cement from 3'-33', welded on steel plate with name and date.

1-9-1980

(If additional description is necessary, use BACK of this sheet)  
Name of Plugging Contractor Lillard Casing Pulling, Inc.  
Address P. O. Box 962 - Woodward, OK 73801

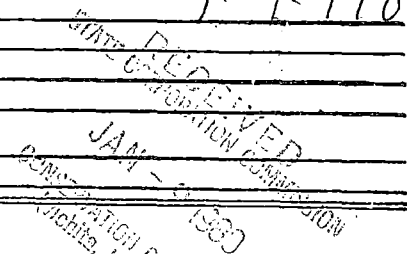

STATE OF COUNTY OF ss.

(employee of owner) or (owner or operator) of the above-described well, being first duly sworn on oath, says: That I have knowledge of the facts, statements, and matters herein contained and the log of the above-described well as filed and that the same are true and correct. So help me God.

(Signature) Charles Whicker

SUBSCRIBED AND SWORN TO before me this 7th day of JANUARY, 1980

(Address) Melinda S. Shudder Notary Public

My commission expires 4-20-83