


WELL PLUGGING RECORD

Give All Information Completely
Make Required Affidavit
Mail or Deliver Report to:
Conservation Division
State Corporation Commission
211 No. Broadway
Wichita, Kansas

Gray County, Sec. 35 Twp. 29S Rge. (Ex) 30 (W)
Location as "NE/CNW/SW" or footage from lines Ctr SE NW

NORTH

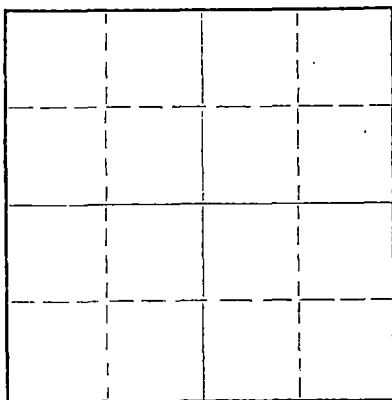

Locate well correctly on above
Section Plat

Lease Owner Texaco Inc.
Lease Name Annah Davenport Well No. 1
Office Address 614 Bitting Bldg., Wichita, Kansas
Character of Well (completed as Oil, Gas or Dry Hole) Lost Hole
Date well completed 2-17- 19 65
Application for plugging filed Verbal 19
Application for plugging approved Verbal 19
Plugging commenced 2-17- 19 65
Plugging completed 2-17- 19 65
Reason for abandonment of well or producing formation Lost last jt of surface casing in hole while drilling @ 3079.
If a producing well is abandoned, date of last production None 19
Was permission obtained from the Conservation Division or its agents before plugging was commenced? Yes

Name of Conservation Agent who supervised plugging of this well Hugh Scott
Producing formation _____ Depth to top _____ Bottom _____ Total Depth of Well _____ Feet
Show depth and thickness of all water, oil and gas formations.

OIL, GAS OR WATER RECORDS

CASING RECORD

FORMATION	CONTENT	FROM	TO	SIZE	PUT IN	PULLED OUT
				8-5/8	1865	None

Describe in detail the manner in which the well was plugged, indicating where the mud fluid was placed and the method or methods used in introducing it into the hole. If cement or other plugs were used, state the character of same and depth placed, from _____ feet to _____ feet for each plug set.

Hole plugged as follows: 3079-700 w/hvy drlg mud, 700-583 w/35 sx cmt, 583-45 w/hvy drlg mud, 45-3 w/15 sx cmt. Comp 3 AM 2-17-65.

RECEIVED
STATE CORPORATION COMMISSION

FEB 23 1965

CONSERVATION DIVISION
Wichita, Kansas

2-23-1965

(If additional description is necessary, use BACK of this sheet)

Name of Plugging Contractor Garvey Drilling Company
Address Wichita, Kansas

STATE OF Kansas, COUNTY OF Sedgwick, ss.
H. N. Wade (employee of owner) or (owner or operator) of the above-described well, being first duly sworn on oath, says: That I have knowledge of the facts, statements, and matters herein contained and the log of the above-described well as filed and that the same are true and correct. So help me God.

(Signature) H. N. Wade Dist. Supt.
614 Bitting Bldg., Wichita, Kansas
(Address)

SUBSCRIBED AND SWORN to before me this 17th day of February, 1965

My commission expires 6-20-68

A. E. Boyd
Notary Public.

15-069-19000-0000
WELL LOG

Please attach to Form
OP-4 dated 2-17-65

COMPANY **Texaco, Inc.**

SEC. 35 T. 29S R. 30W

FARM **Davenport**

NO. 1

LOC. SE NW


TOTAL DEPTH **3079'**

COUNTY **Gray**

COMM. **2-3-65**

COMP. **2-17-65**

CONTRACTOR **Garvey Drilling Company**

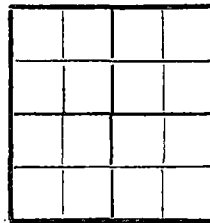

CASING **8 5/8" @ 1865' w/750 sx**

ELEVATION

PRODUCTION **Abandoned**

FIGURES INDICATE BOTTOM OF FORMATIONS

- 670' Clay and Sand
- 1085' Red Bed
- 1200' Gyp and Red Rock
- 1390' Glorietta
- 1410' Shale
- 1660' Shale and Shells
- 1775' Shale and Anhydrite Streaks
- 1865' Shale and Anhydrite
- 2200' Red Bed and Shale
- 2580' Shale and Lime
- 3079' Lime and Shale
- 3079' RTD

Hole abandoned due to the parting of surface casing.

RECEIVED
STATE CORPORATION COMMISSION

APR 22 1965

CONSERVATION DIVISION
Wichita, Kansas

State of **Kansas**

County of **Barton**

I, **Sam N. Stephens** of **Garvey Drilling Company**

upon oath state the above and foregoing is a true and correct copy of the log of the **Davenport #1** well.

Subscribed and sworn to before me this **25th** day of **February** 19 **65**

My Commission Expires: **October 19th, 1968**

Sam N. Stephens
Notary Public

NOTARY PUBLIC